REVISIONS			
SYM	DESCRIPTION	DATE	APPROVED
1	AS BUILT 6" FIRE LINE TO BLDG. 075	12-18-72	McKEAN

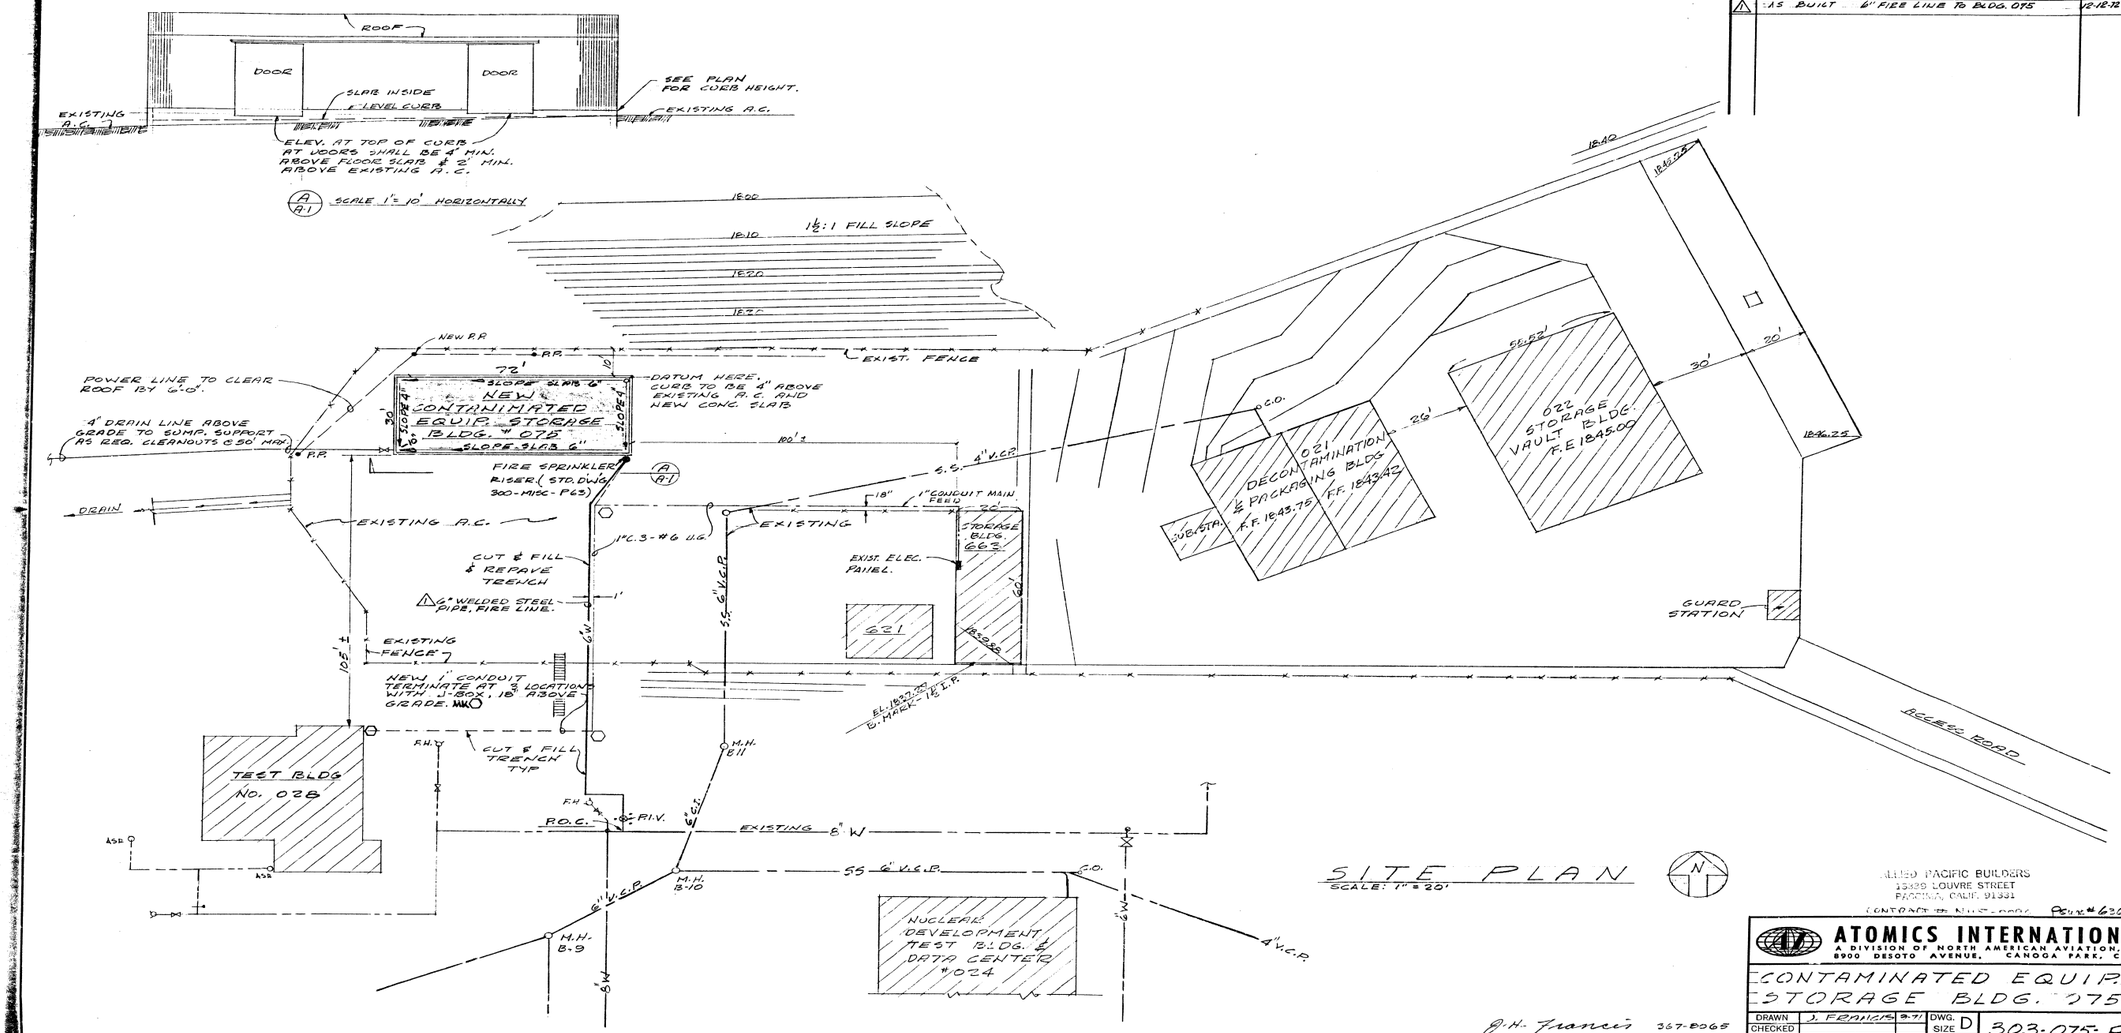

ALLIED PACIFIC BUILDERS
15329 LOUVRE STREET
PACOIMA, CALIF. 91331
CONTRACT NO. NAS7-[illegible] PO NO. # 63292

ATOMICS INTERNATIONAL
A DIVISION OF NORTH AMERICAN AVIATION, INC.
8900 DESOTO AVENUE, CANOGA PARK, CALIF.

CONTAMINATED EQUIP. STORAGE BLDG. 075

DRAWN	J. FRANCIS	9-71	DWG. SIZE D	303-075-P1
CHECKED				
ENGINEER	J. FENNOYS	9-71	SCALE 1" = 20'	
APPROVED			SHEET NO. ____ OF ____	

D.H. Francis 357-8065
SE. 1285
12223 FRANKLIN BLVD 91342

FORM N94-B-7 NEW 7-68

DIETERICH-POST CLEARPRINT 1020-B