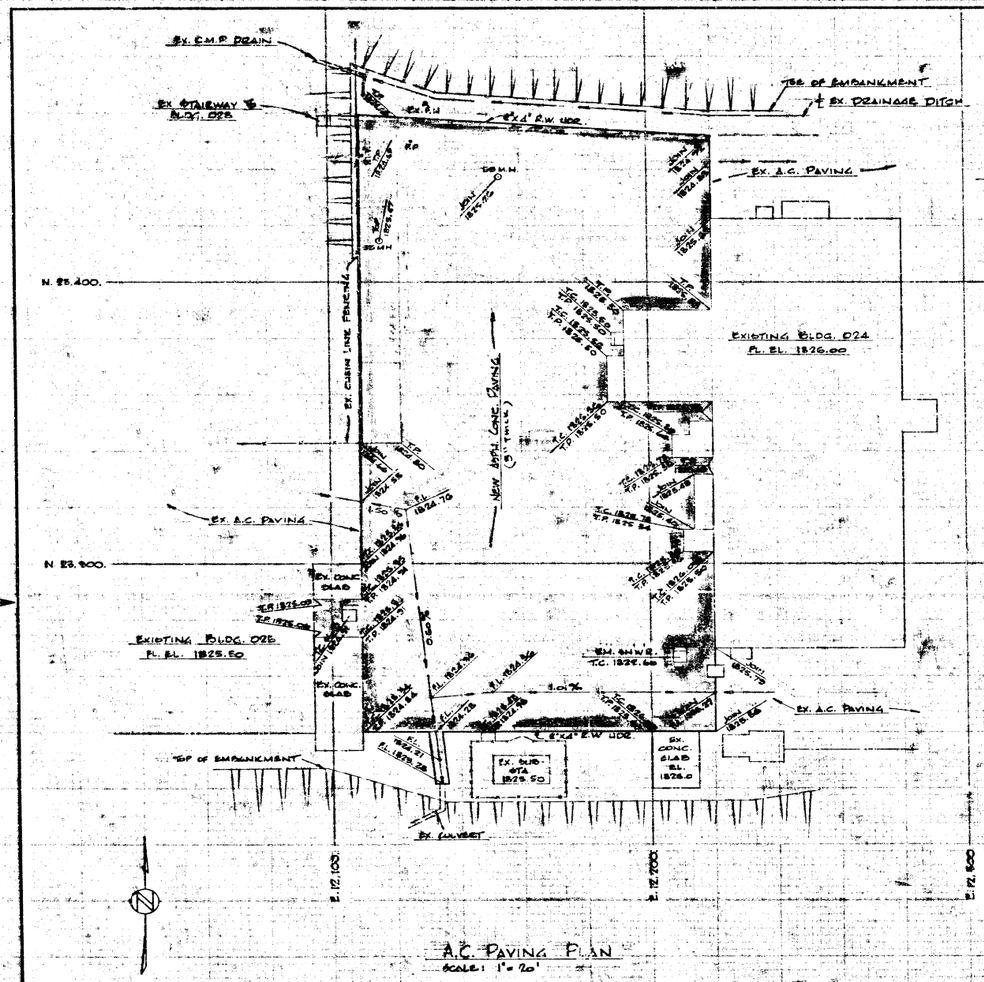

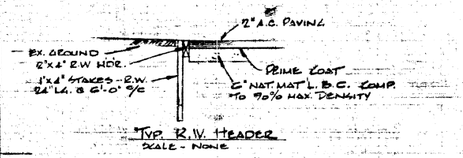

TYP. R.W. HEADER
SCALE - NONE

A.C. PAVING PLAN
SCALE: 1" = 20'

ABBREVIATIONS:
- T.C. TOP OF CONCRETE
- T.P. TOP OF PAVEMENT
- F.L. FLOW LINE
- P.P. POWER POLE
- SS M.H. SAN. SEWER MANHOLE
- F.H. FIRE HYDRANT

REVISIONS

AS BUILT	SYM	DESCRIPTION	DATE	APPROVED
	A	AS BUILT RECORDED	7/64	N.J.

T.W.R. 26154

ATOMICS INTERNATIONAL
A DIVISION OF NORTH AMERICAN AVIATION, INC.
8900 DESOTO AVENUE, CANOGA PARK, CALIF.

ASPH. CONC. PAVING
A.E.T.F. BLDG. 024 PLANS & DETAILS

DRAWN		DWG.	D
CHECKED		SIZE	
ENGINEER		SCALE	
APPROVED			

BOA-724-C 6

SHEET NO. 1 OF 1

REDUCED DRAWING