REVISIONS			
SYM	DESCRIPTION	DATE	SIGNATURE
1	INSTALL LAMP GUARD ON FIXTURE	11/6/61	PAN
2	AS BUILT	6/18/62	G.F.

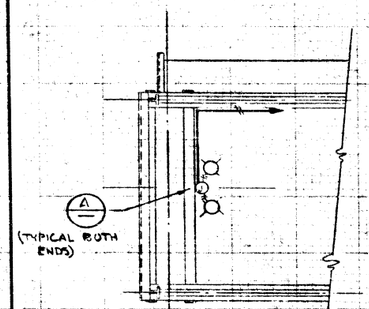

PLAN VIEW
1/2" = 1'-0

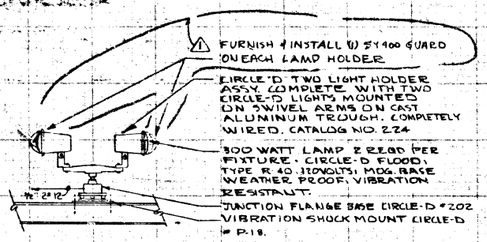

LIGHT FIXTURE DETAIL (A)
NO SCALE

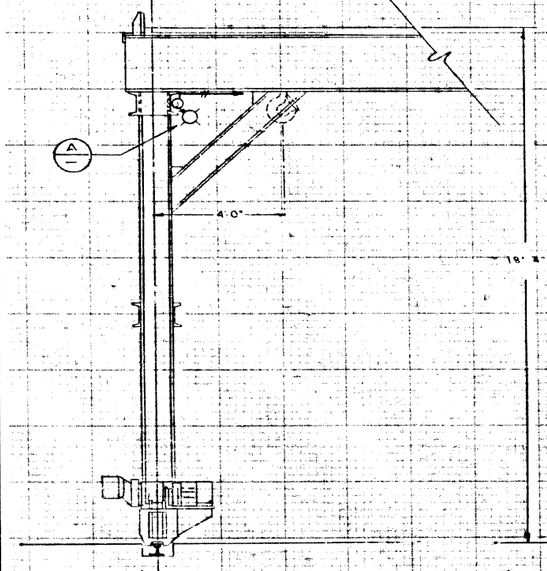

WEST ELEVATION
1/2" = 1'-0

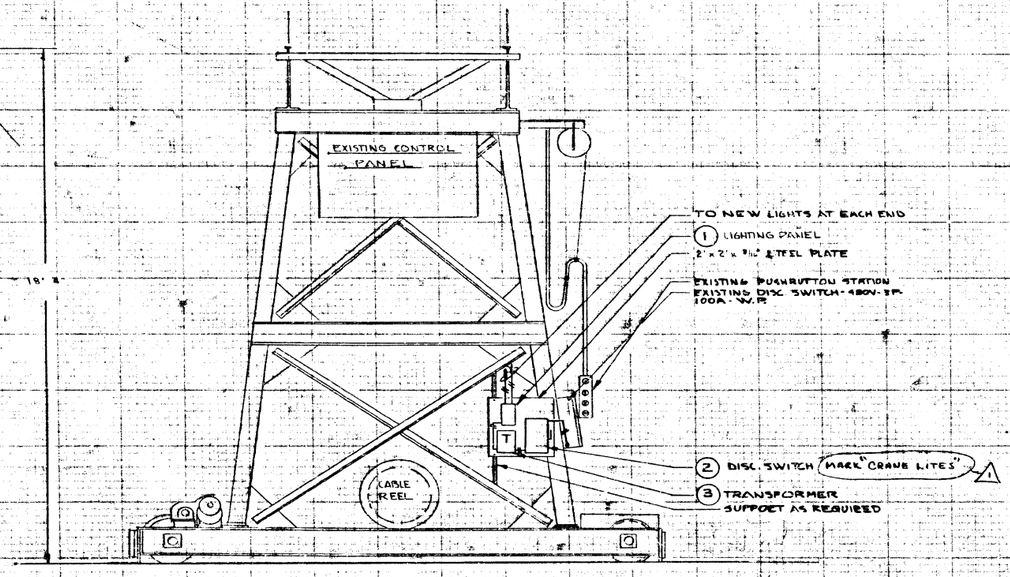

SOUTH ELEVATION
1/2" = 1'-0

SPECIAL NOTES

1. LIGHTING PANEL - SQ.D# Q02 RO COMPLETE WITH (2) - 1P - 20A - 120V CIRCUIT BREAKERS
2. DISCONNECT SWITCH SQ.D# A85341 RO - 3 POLE 480V - SINGLE THROW, FUSIBLE, GENERAL PURPOSE, RAINTIGHT, 30 AMP
3. TRANSFORMER - WESTINGHOUSE # 323B701A15 1500 VA - 480V - 120/240, FRAME 24, TYPE "EP" ENCLOSED TYPE FOR OUTDOOR INSTALLATION

303-024-E11

TWR 24677
JIR 782-54813

REDUCED DRAWING

NOTICE

THIS DRAWING INVOLVES CONFIDENTIAL PROPRIETARY DESIGN INFORMATION OF ATOMICS INTERNATIONAL, A DIVISION OF NORTH AMERICAN AVIATION, INC. AND ALL RIGHTS ARE EXPRESSLY RESERVED. IT IS SUBMITTED UNDER A TRUST RELATIONSHIP FOR A SPECIFIED PURPOSE. IT IS AGREED THAT IT WILL NOT BE USED FOR ANY OTHER PURPOSE, NOR ITS CONTENTS REVEALED TO ANYONE EXCEPT FOR THAT PURPOSE, NOR COPIED IN WHOLE OR IN PART, NOR ITS DESIGN FEATURES USED IN OTHER PROJECTS. IT WILL BE RETURNED TO ATOMICS INTERNATIONAL WHEN NO LONGER REQUIRED OR UPON REQUEST.

ATOMICS INTERNATIONAL
A DIVISION OF NORTH AMERICAN AVIATION, INC.
8900 DESOTO AVENUE, CANOGA PARK, CA 91.

ENVIRONMENTAL TEST BLDG #024
SANTA SUSANA
LIGHTING 20 TON GANTRY CRANE

DRAWN	MISSADES	6/61	DWG. SIZE D	303-024-E11
CHECKED				
ENGINEER	MISSADES	9/61	SCALE NOTED	
APPROVED	[signature]	9/61		SHEET NO. ___ OF ___