REVISIONS				
AS BUILT	SYM	DESCRIPTION	DATE	SIGNATURE
	B	AS BUILT	1/64	

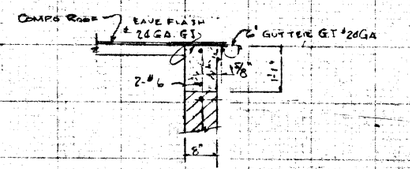

EAVE DETAIL 3/4"=1'-0"
(1) SO. WALL ONLY

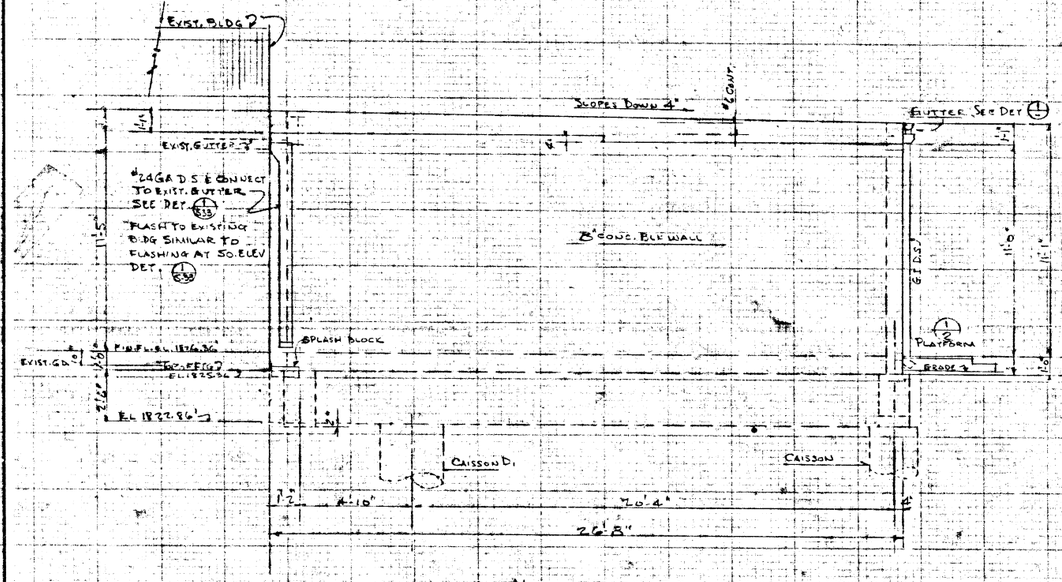

NORTH ELEVATION

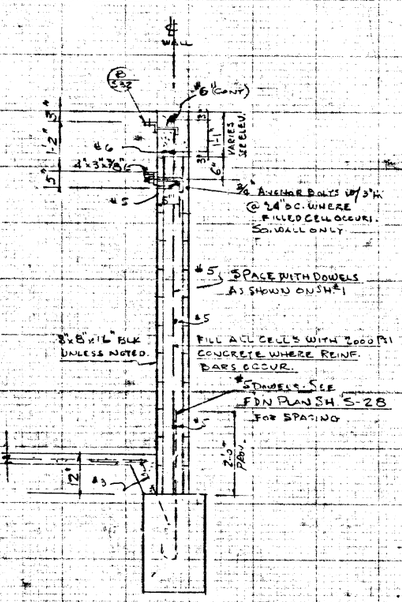

TYP. WALL SECTION

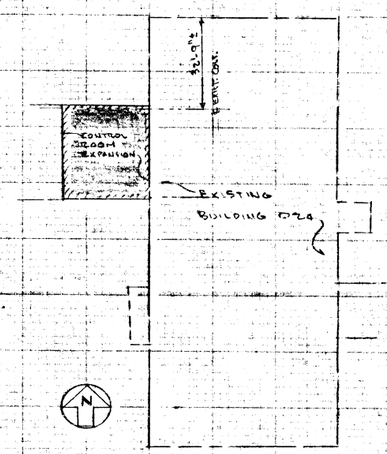

LOCATION PLAN
1"=20'

TWR 34019

NOTICE

THIS DRAWING INVOLVES CONFIDENTIAL PROPRIETARY DESIGN INFORMATION OF ATOMICS INTERNATIONAL, A DIVISION OF NORTH AMERICAN AVIATION, INC. AND ALL RIGHTS ARE EXPRESSLY RESERVED. IT IS SUBMITTED UNDER A TRUST RELATIONSHIP FOR LIMITED PURPOSE. IT IS UNDERSTOOD THAT IT WILL NOT BE USED FOR ANY OTHER PURPOSE, NOR ITS CONTENTS DIVULGED TO ANYONE EXCEPT FOR THAT PURPOSE, NOR COPIED IN WHOLE OR IN PART. NOR ITS DESIGN FEATURES USED IN OTHER PROJECTS. IT SHALL BE RETURNED TO ATOMICS INTERNATIONAL WHEN NO LONGER REQUIRED OR UPON REQUEST.

ATOMICS INTERNATIONAL
A DIVISION OF NORTH AMERICAN AVIATION, INC.
8900 DESOTO AVENUE, CANOGA PARK, CALIF.

SETF CONTROL ROOM EXPANSION
NORTH ELEVATION EXTENSION TO BLDG 024

DRAWN			DWG. SIZE D	303-024-S34
CHECKED			SCALE 1/4"=1'-0"	
ENGINEER				
APPROVED				SHEET NO. 7 OF

REDUCED DRAWING