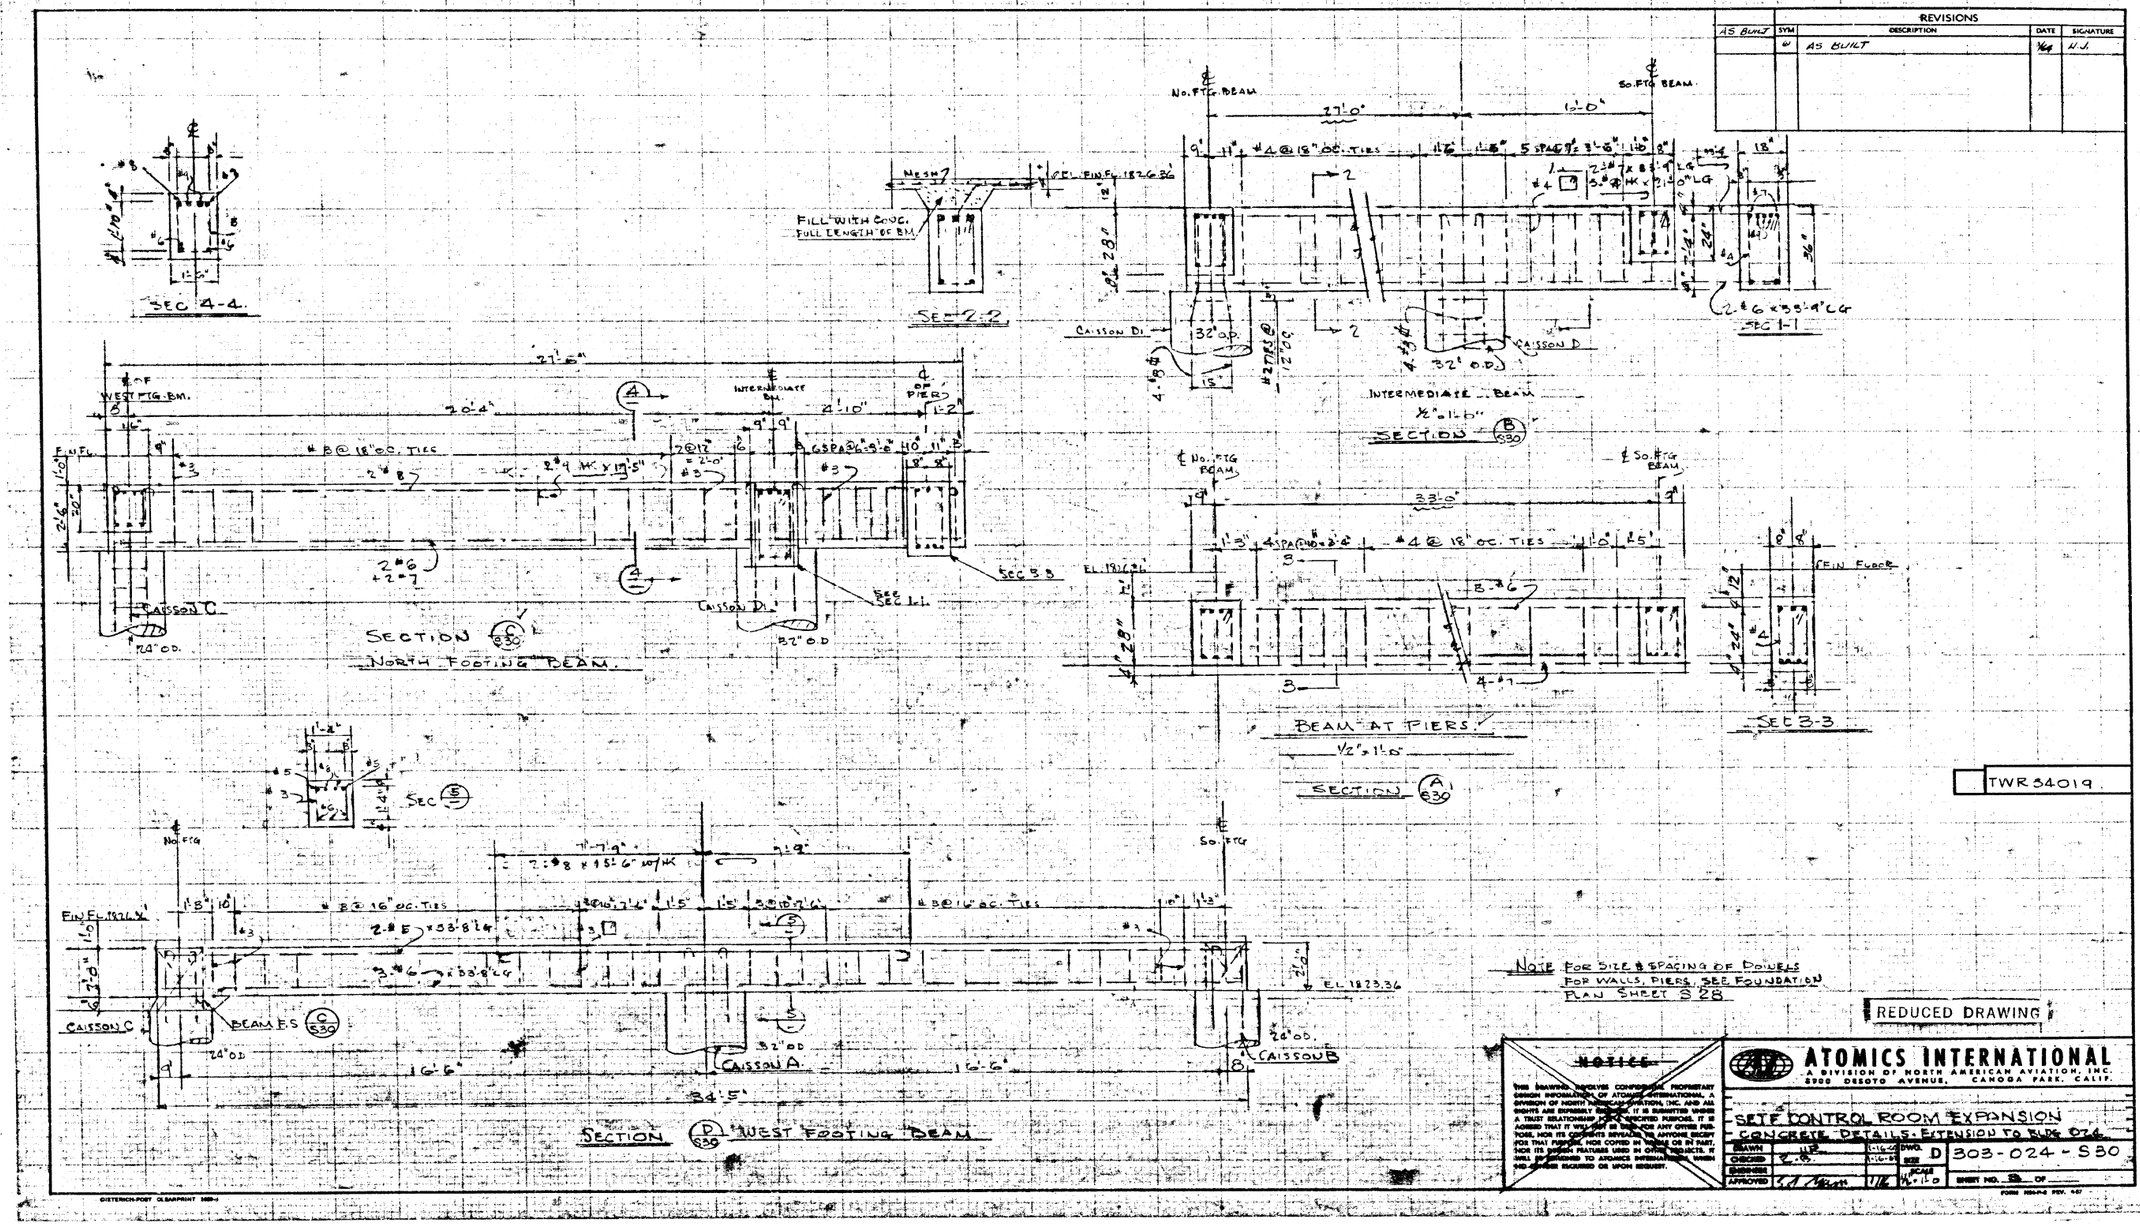

REVISIONS				
AS BUILT	SYM	DESCRIPTION	DATE	SIGNATURE
	0	AS BUILT	1/64	N.J.

TWR 34019

NOTE FOR SIZE & SPACING OF DOWELS FOR WALLS, PIERS, SEE FOUNDATION PLAN SHEET S 28

REDUCED DRAWING

CONCRETE DETAILS

NOTICE

THIS DRAWING INVOLVES CONFIDENTIAL PROPRIETARY DESIGN INFORMATION OF ATOMICS INTERNATIONAL, A DIVISION OF NORTH AMERICAN AVIATION, INC. AND ALL RIGHTS ARE EXPRESSLY RESERVED. IT IS SUBMITTED UNDER A TRUST RELATIONSHIP FOR A SPECIFIED PURPOSE. IT IS AGREED THAT IT WILL NOT BE USED FOR ANY OTHER PURPOSE, NOR ITS CONTENTS REVEALED TO ANYONE EXCEPT FOR THAT PURPOSE, NOR COPIED IN WHOLE OR IN PART, NOR ITS DESIGN FEATURES USED IN OTHER PROJECTS. IT WILL BE RETURNED TO ATOMICS INTERNATIONAL WHEN NO LONGER REQUIRED OR UPON REQUEST.

ATOMICS INTERNATIONAL
A DIVISION OF NORTH AMERICAN AVIATION, INC.
8900 DESOTO AVENUE, CANOGA PARK, CALIF.

SETF CONTROL ROOM EXPANSION
CONCRETE DETAILS - EXTENSION TO BLDG 024

DRAWN	[illegible]	1-16-64	DWG. SIZE D	303-024-S30
CHECKED	[illegible]	1-16-64		
ENGINEER			SCALE 1/4"=1'-0"	SHEET NO. 3 OF
APPROVED	[illegible]	1/16		

FORM [illegible] REV. 4-67

DIETERICH-POST CLEARPRINT [illegible]