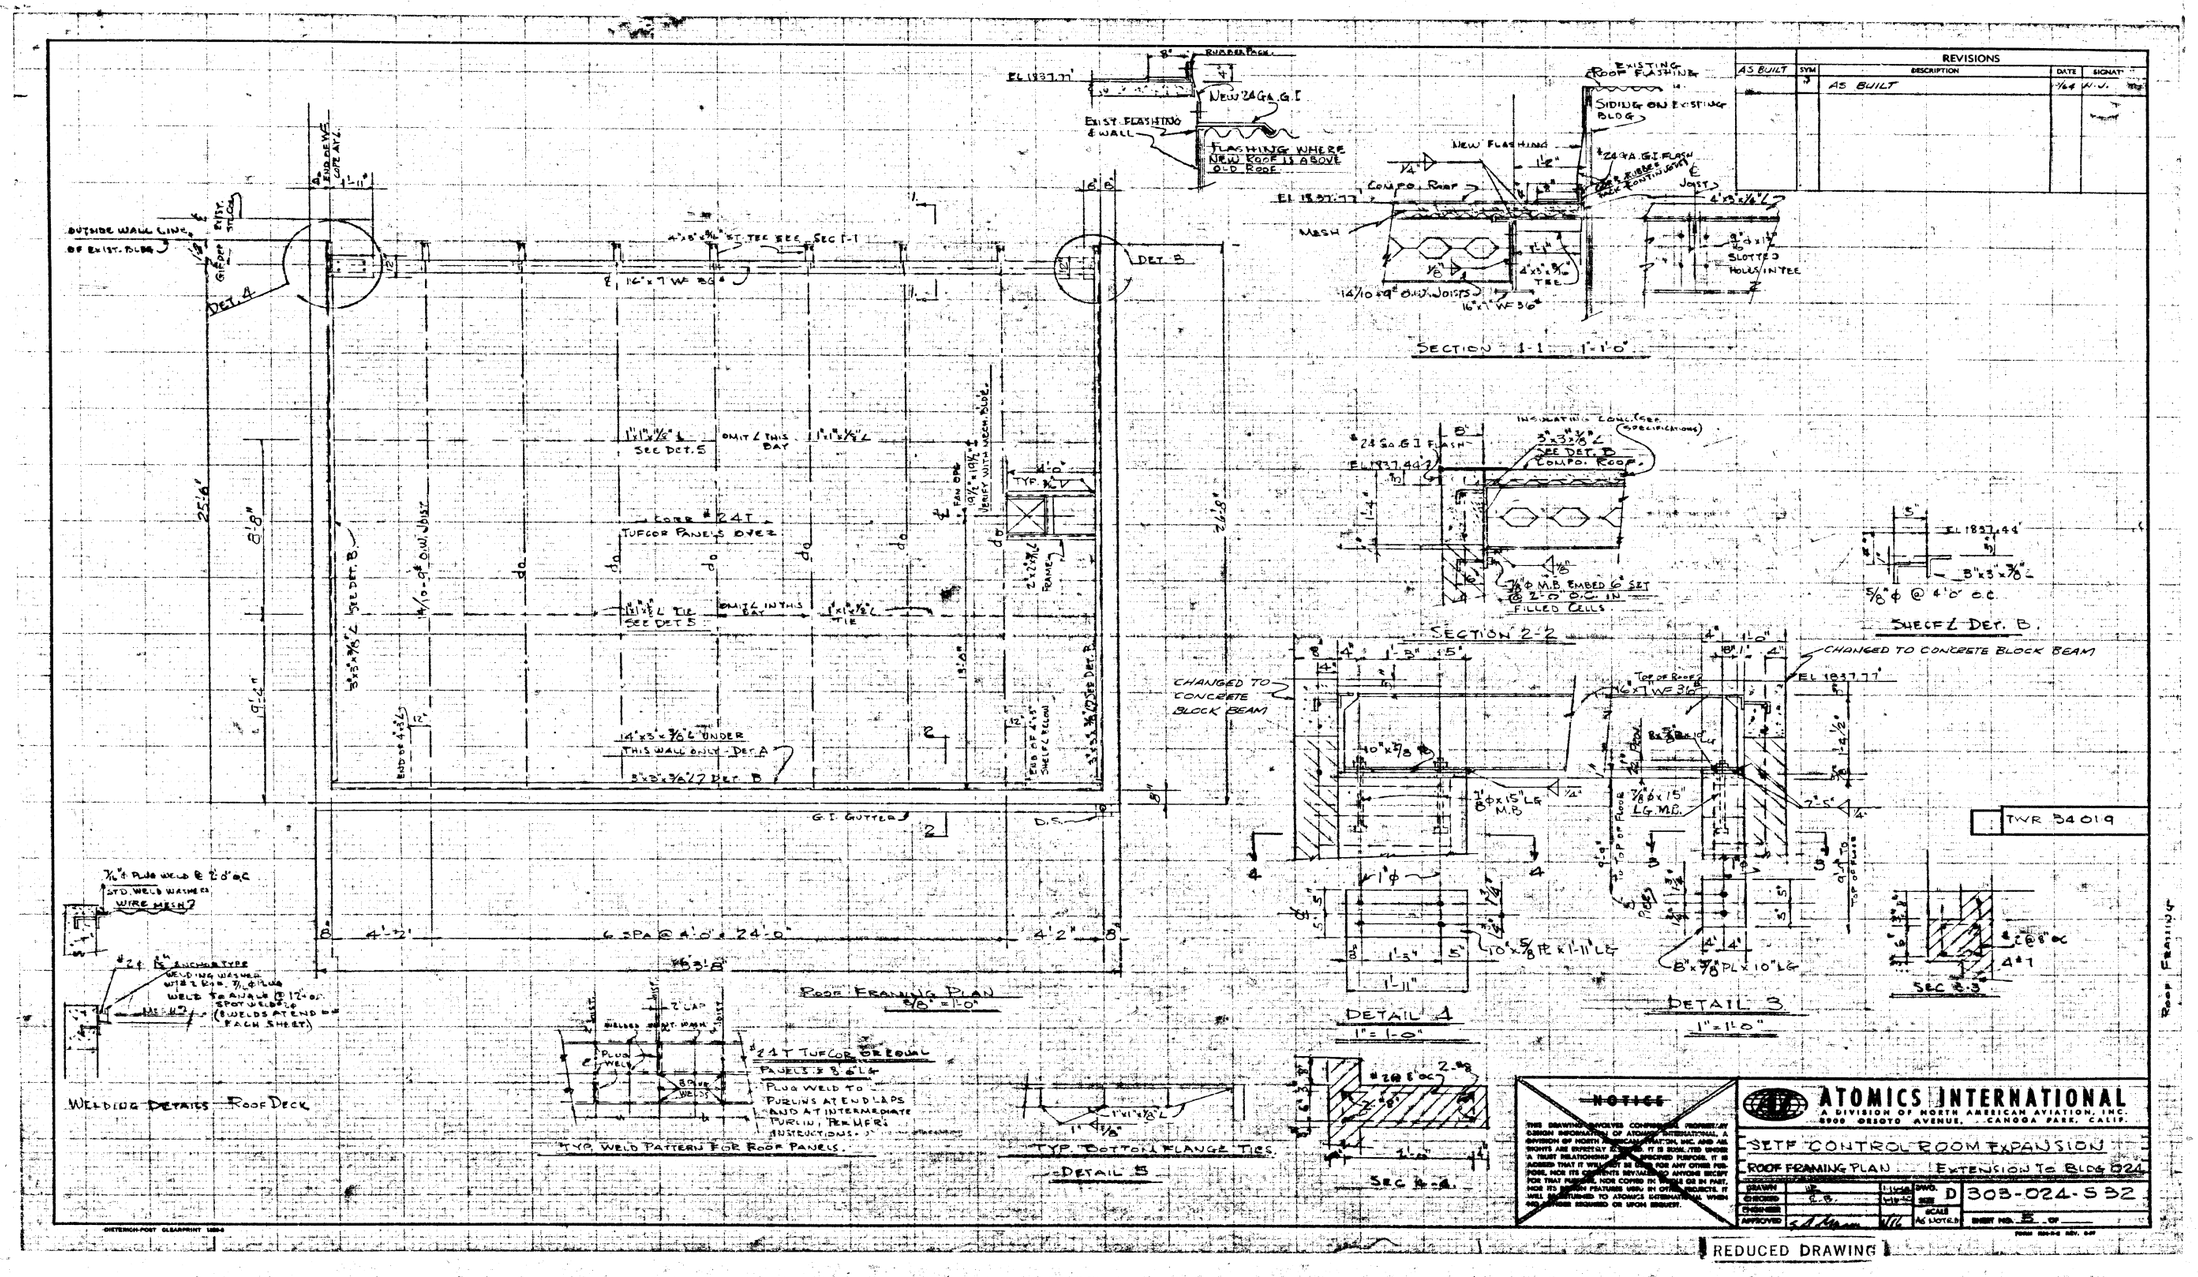

REVISIONS
AS BUILT
SYM
DESCRIPTION
DATE
SIGNAT
AS BUILT
SECTION 1-1 1"=1'-0"
SECTION 2-2
DETAIL 4
1"=1'-0"
DETAIL 3
1"=1'-0"
SHELF ∠ DET. B.
ROOF FRAMING PLAN
3/8"=1'-0"
WELDING DETAILS ROOF DECK
TYP. WELD PATTERN FOR ROOF PANELS.
TYP. BOTTOM FLANGE TIES.
DETAIL 5
CHANGED TO CONCRETE BLOCK BEAM
NOTICE
ATOMICS INTERNATIONAL
A DIVISION OF NORTH AMERICAN AVIATION, INC.
8900 OSSOTO AVENUE, CANOGA PARK, CALIF.
SETF CONTROL ROOM EXPANSION
ROOF FRAMING PLAN
EXTENSION TO BLDG 024
D
303-024-S32
SCALE AS NOTED
SHEET NO. 5
REDUCED DRAWING