REVISIONS				
AS BUILT	SYM	DESCRIPTION	DATE	SIGNATURE
	F	AS BUILT	1/68	N.J.

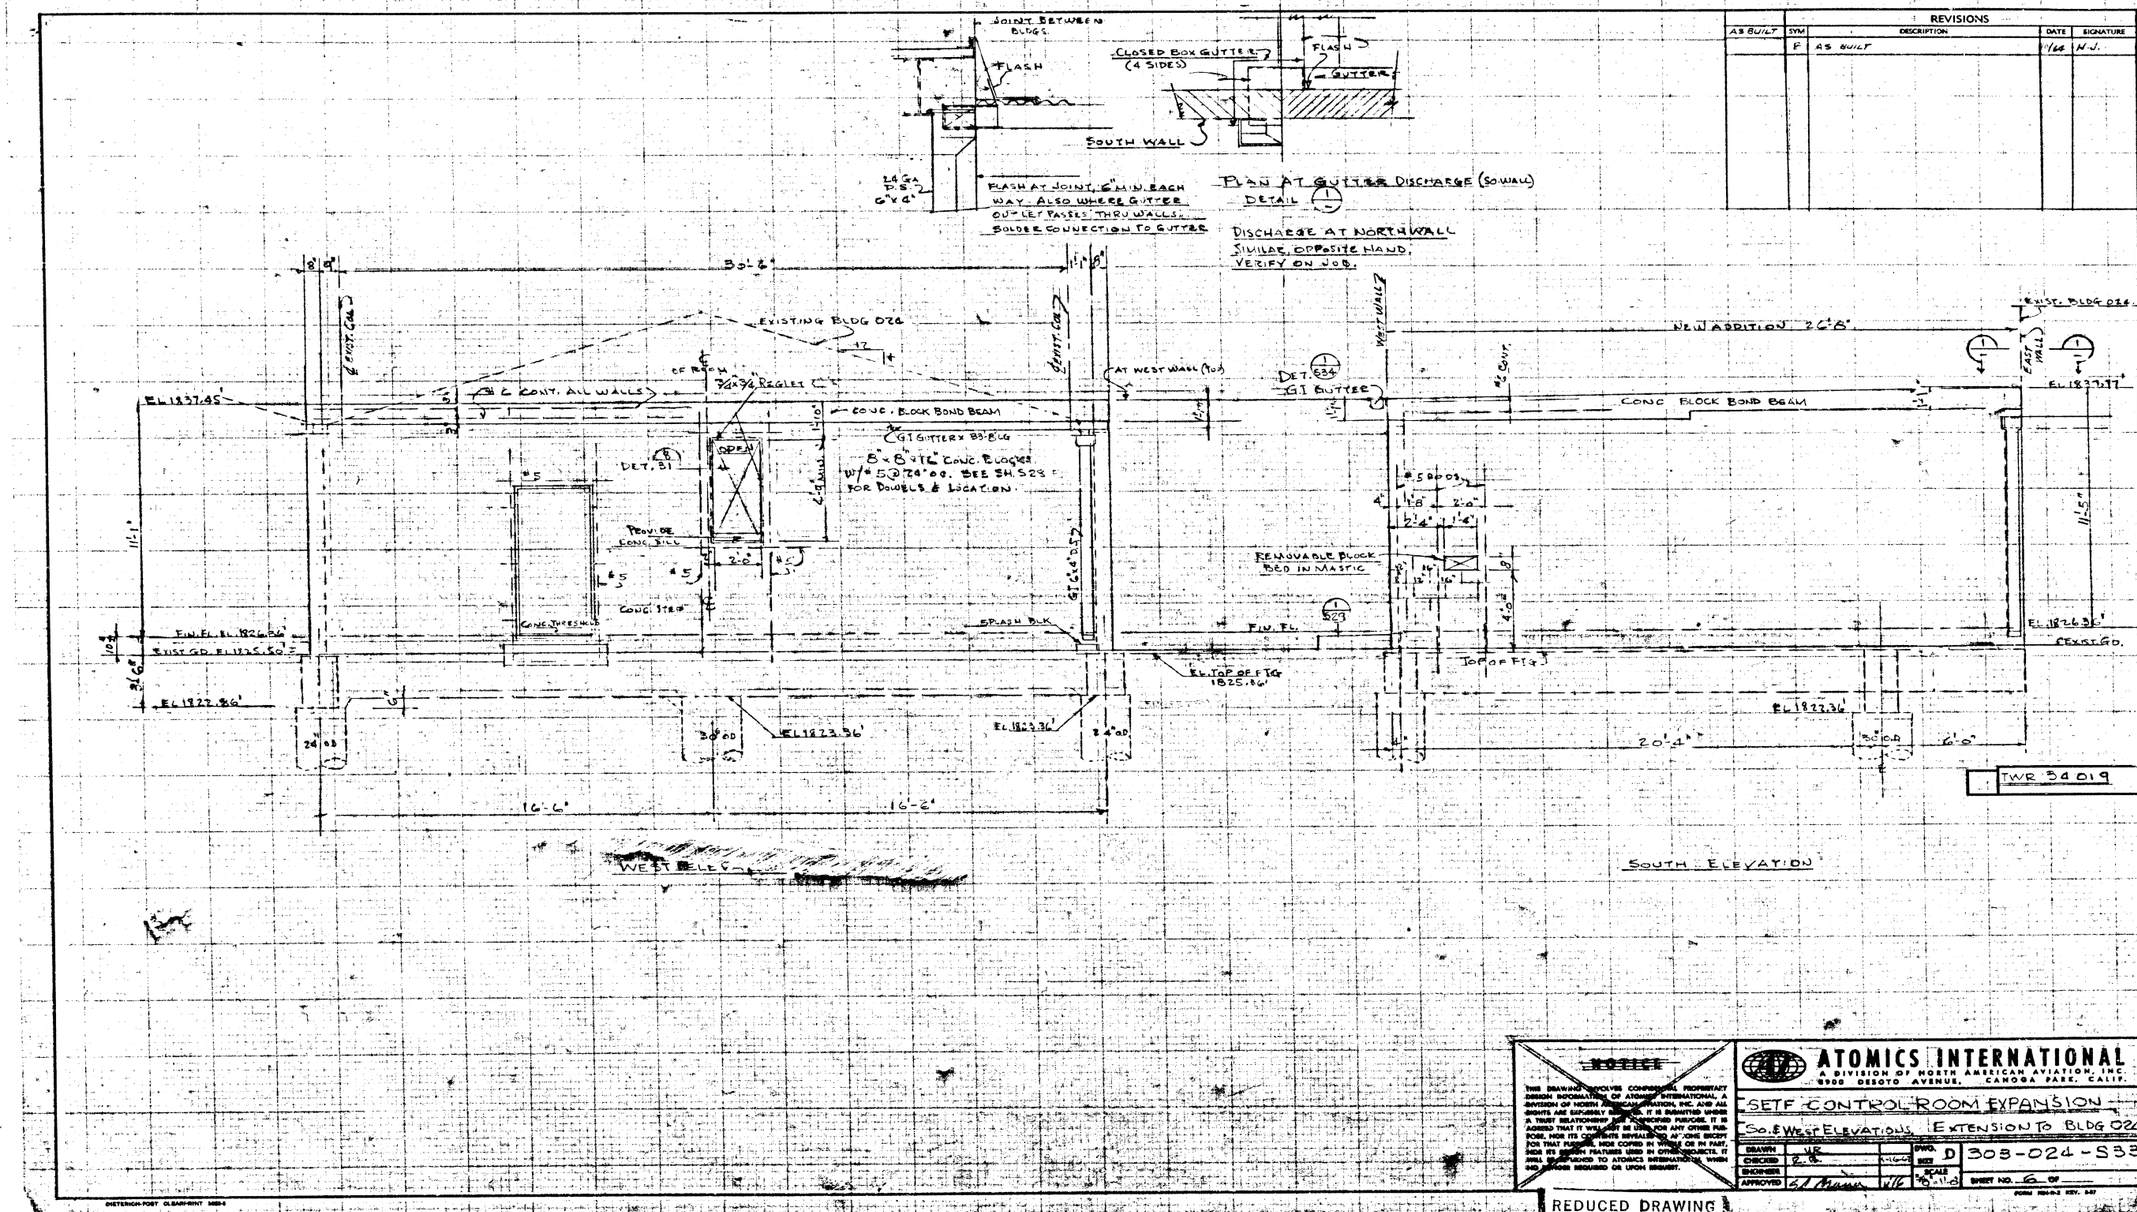

NOTICE

THIS DRAWING INVOLVES CONFIDENTIAL PROPRIETARY DESIGN INFORMATION OF ATOMICS INTERNATIONAL, A DIVISION OF NORTH AMERICAN AVIATION, INC. AND ALL RIGHTS ARE EXPRESSLY RESERVED. IT IS SUBMITTED UNDER A TRUST RELATIONSHIP FOR LIMITED PURPOSE. IT IS AGREED THAT IT WILL NOT BE USED FOR ANY OTHER PURPOSE, NOR ITS CONTENTS REVEALED TO ANYONE EXCEPT FOR THAT PURPOSE, NOR COPIED IN WHOLE OR IN PART, NOR ITS DESIGN FEATURES USED IN OTHER PROJECTS. IT SHALL BE RETURNED TO ATOMICS INTERNATIONAL WHEN NO LONGER REQUIRED OR UPON REQUEST.

REDUCED DRAWING

ATOMICS INTERNATIONAL
A DIVISION OF NORTH AMERICAN AVIATION, INC.
8900 DESOTO AVENUE, CANOGA PARK, CALIF.

SETF CONTROL ROOM EXPANSION
So. & West Elevations, Extension to Bldg 024

DRAWN	J.L.R.		DWG. SIZE D	303-024-S33
CHECKED	E.R.	1-16-68		
ENGINEER			SCALE 3/8"=1'-0"	SHEET NO. 6 OF
APPROVED	E.J. Mann	1/16		

FORM 1514-D-2 REV. 5-67

DIETERICH-POST CLEAR-PRINT 1020-2