REVISIONS				
AS BUILT	SYM	DESCRIPTION	DATE	SIGNATURE
	0	AS BUILT	9/64	H.J.

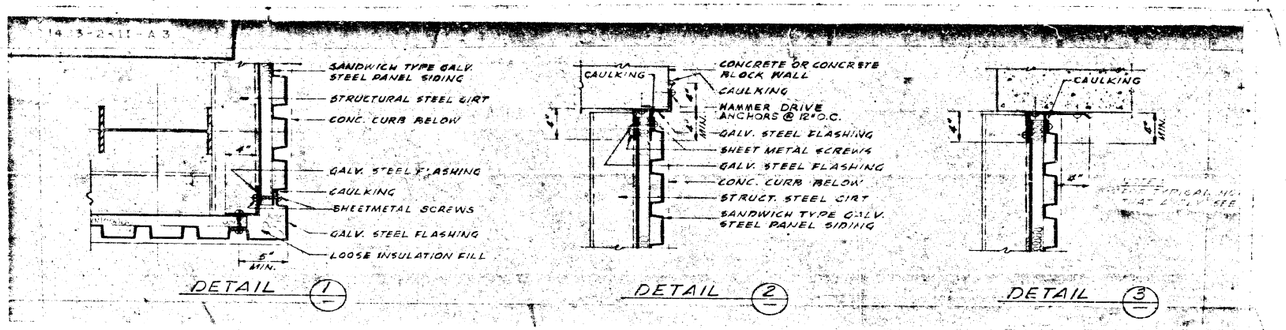

EXISTING FLASHING DETAILS

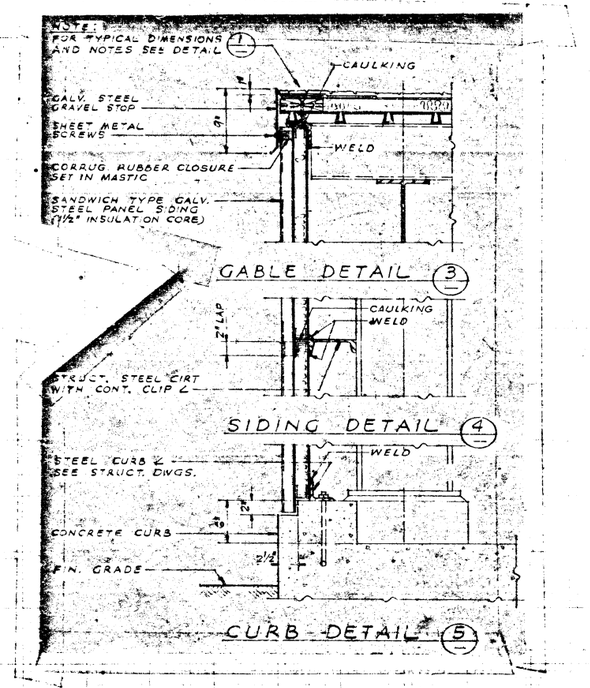

EXISTING DETAILS

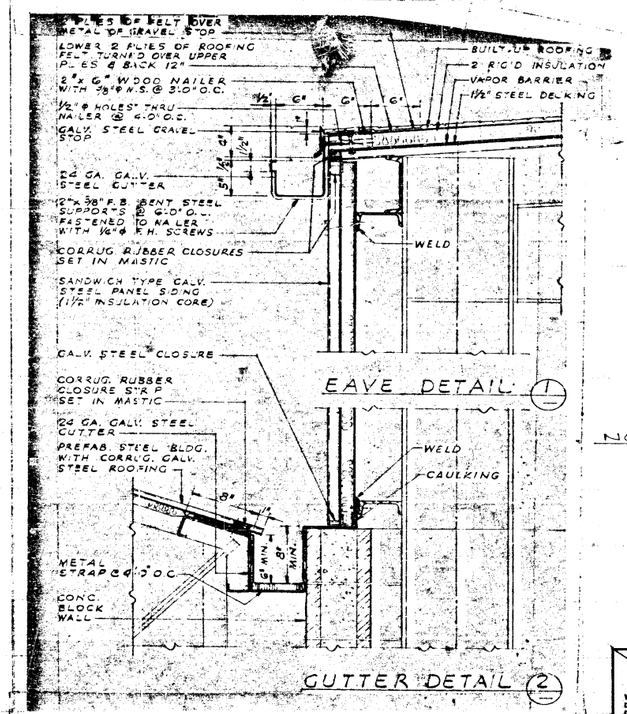

EXISTING DETAILS

TWR- 24677
JIR- 782- 54813
TWR 32648

NOTE: ALL SECTIONS AND DETAILS ON THIS SHEET ARE REPRODUCED FROM THE ORIGINAL BUILDING DRAWINGS. THE BUILDER SHALL BE GOVERNED BY THESE DETAILS AND SECTIONS, IN WHOLE OR PART, WHEREVER THEY ARE APPLICABLE.

REDUCED DRAWING

1-32-6

NOTICE

THIS DRAWING INVOLVES CONFIDENTIAL PROPRIETARY DESIGN INFORMATION OF ATOMICS INTERNATIONAL, A DIVISION OF NORTH AMERICAN AVIATION, INC., AND ALL RIGHTS ARE EXPRESSLY RESERVED. IT IS SUBMITTED UNDER A TRUST RELATIONSHIP FOR A SPECIFIED PURPOSE. IT IS AGREED THAT IT WILL NOT BE USED FOR ANY OTHER PURPOSE, NOR ITS CONTENTS REVEALED TO ANYONE EXCEPT FOR THAT PURPOSE, NOR COPIED IN WHOLE OR IN PART, NOR ITS DESIGN FEATURES USED IN OTHER PROJECTS. IT WILL BE RETURNED TO ATOMICS INTERNATIONAL WHEN NO LONGER REQUIRED OR UPON REQUEST.

ATOMICS INTERNATIONAL
A DIVISION OF NORTH AMERICAN AVIATION, INC.
8900 DESOTO AVENUE, CANOGA PARK, CALIF.

S.E.T.F. - MODIFICATIONS - BLDG 024
STRUCTURAL DETAILS & SECTIONS

DRAWN	M.S.	9-61	DWG. SIZE D	303-024-514
CHECKED	BROSLOW	9-61		
ENGINEER	M.S.	9-61	SCALE NOTED	SHEET NO. ___ OF ___
APPROVED	[illegible]	[illegible]		

FORM NSA-R-2 REV. 8-8

DIETERICI-POST CLEARPRINT 1000-8