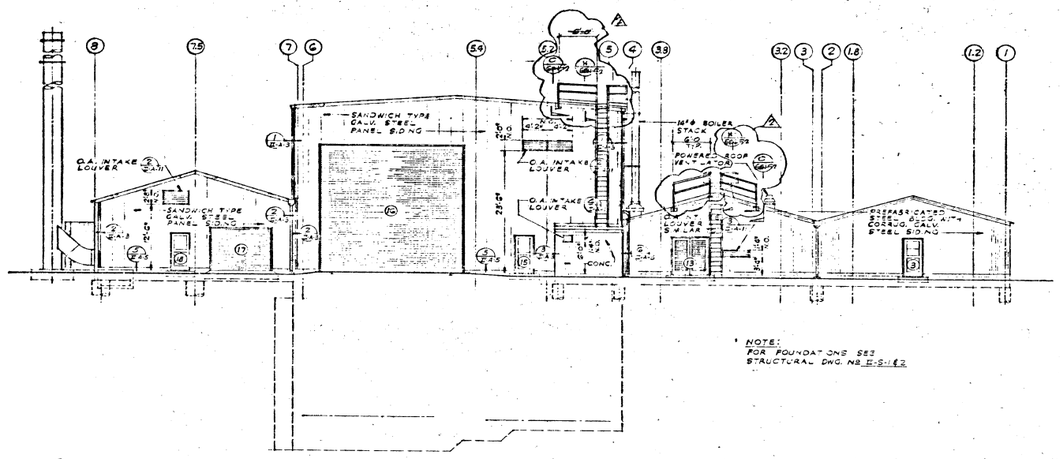

NOTE:
FOR FOUNDATIONS SEE STRUCTURAL DWG. NS II-S-1-12

EAST ELEVATION
SCALE: 1/8" = 1'-0"

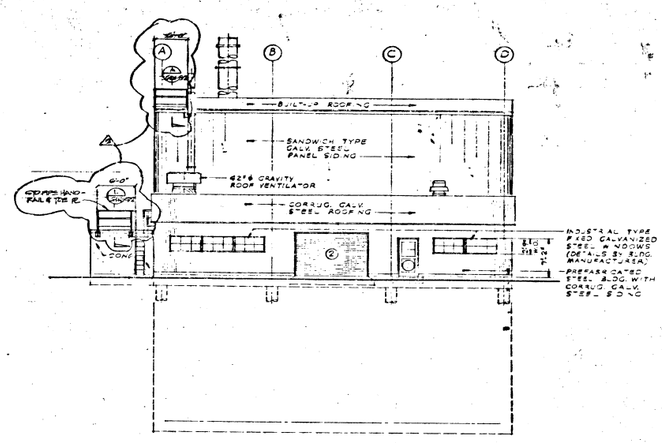

NORTH ELEVATION
SCALE: 1/8" = 1'-0"

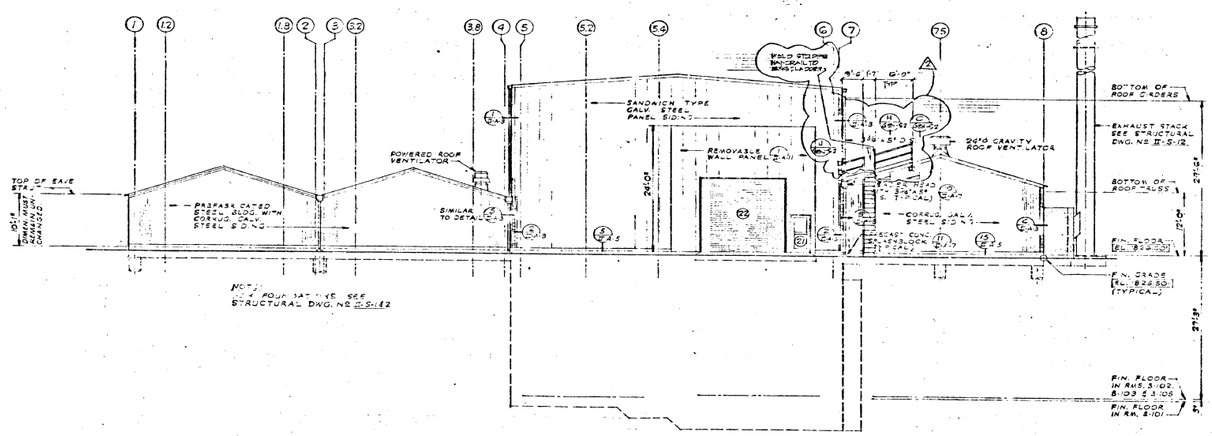

NOTE:
FOR FOUNDATIONS SEE STRUCTURAL DWG. NS II-S-1-12

WEST ELEVATION
SCALE: 1/8" = 1'-0"

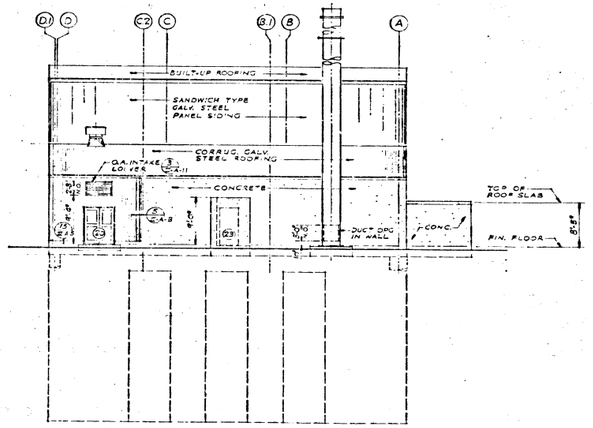

SOUTH ELEVATION
SCALE: 1/8" = 1'-0"

REFERENCE DRAWING											

APPROVED 4-29-59
U.S. ATOMIC ENERGY COMMISSION

CLIENT APPROVAL	NO.	DATE	REVISIONS	BY	CK.	APPROVED

CLIENT APPROVAL	NO.	DATE	REVISIONS	BY	CK.	APPROVED
	A	4-29-59	ISSUED FOR BID	R.K.M.		
	1	5-15-59	AS BUILT	R.K.M.		
	0	4-15-59	ISSUED FOR CLIENT APPROVAL	R.K.M.		

DESIGN L. ARVIE
DRWN. SP
APP'D M. GRAY
DATE FEB. 1959
APP'D M. GRAY
DATE FEB. 1959
SCALE AS SHOWN
DATE 5-29-59

SNAP-II FACILITY, SANTA SUSANA, CALIFORNIA
PHASE II
U.S. ATOMIC ENERGY COMMISSION
CHICAGO OPERATIONS OFFICE

ENVIRONMENTAL TEST BUILDING
ELEVATIONS
ARCHITECTURAL

THE RALPH M. PARSONS COMPANY
LOS ANGELES

913-022-A2
1482-2-11-A-2

REV. 1

PRINTED IN U.S.A.

HALF SIZE PRINT