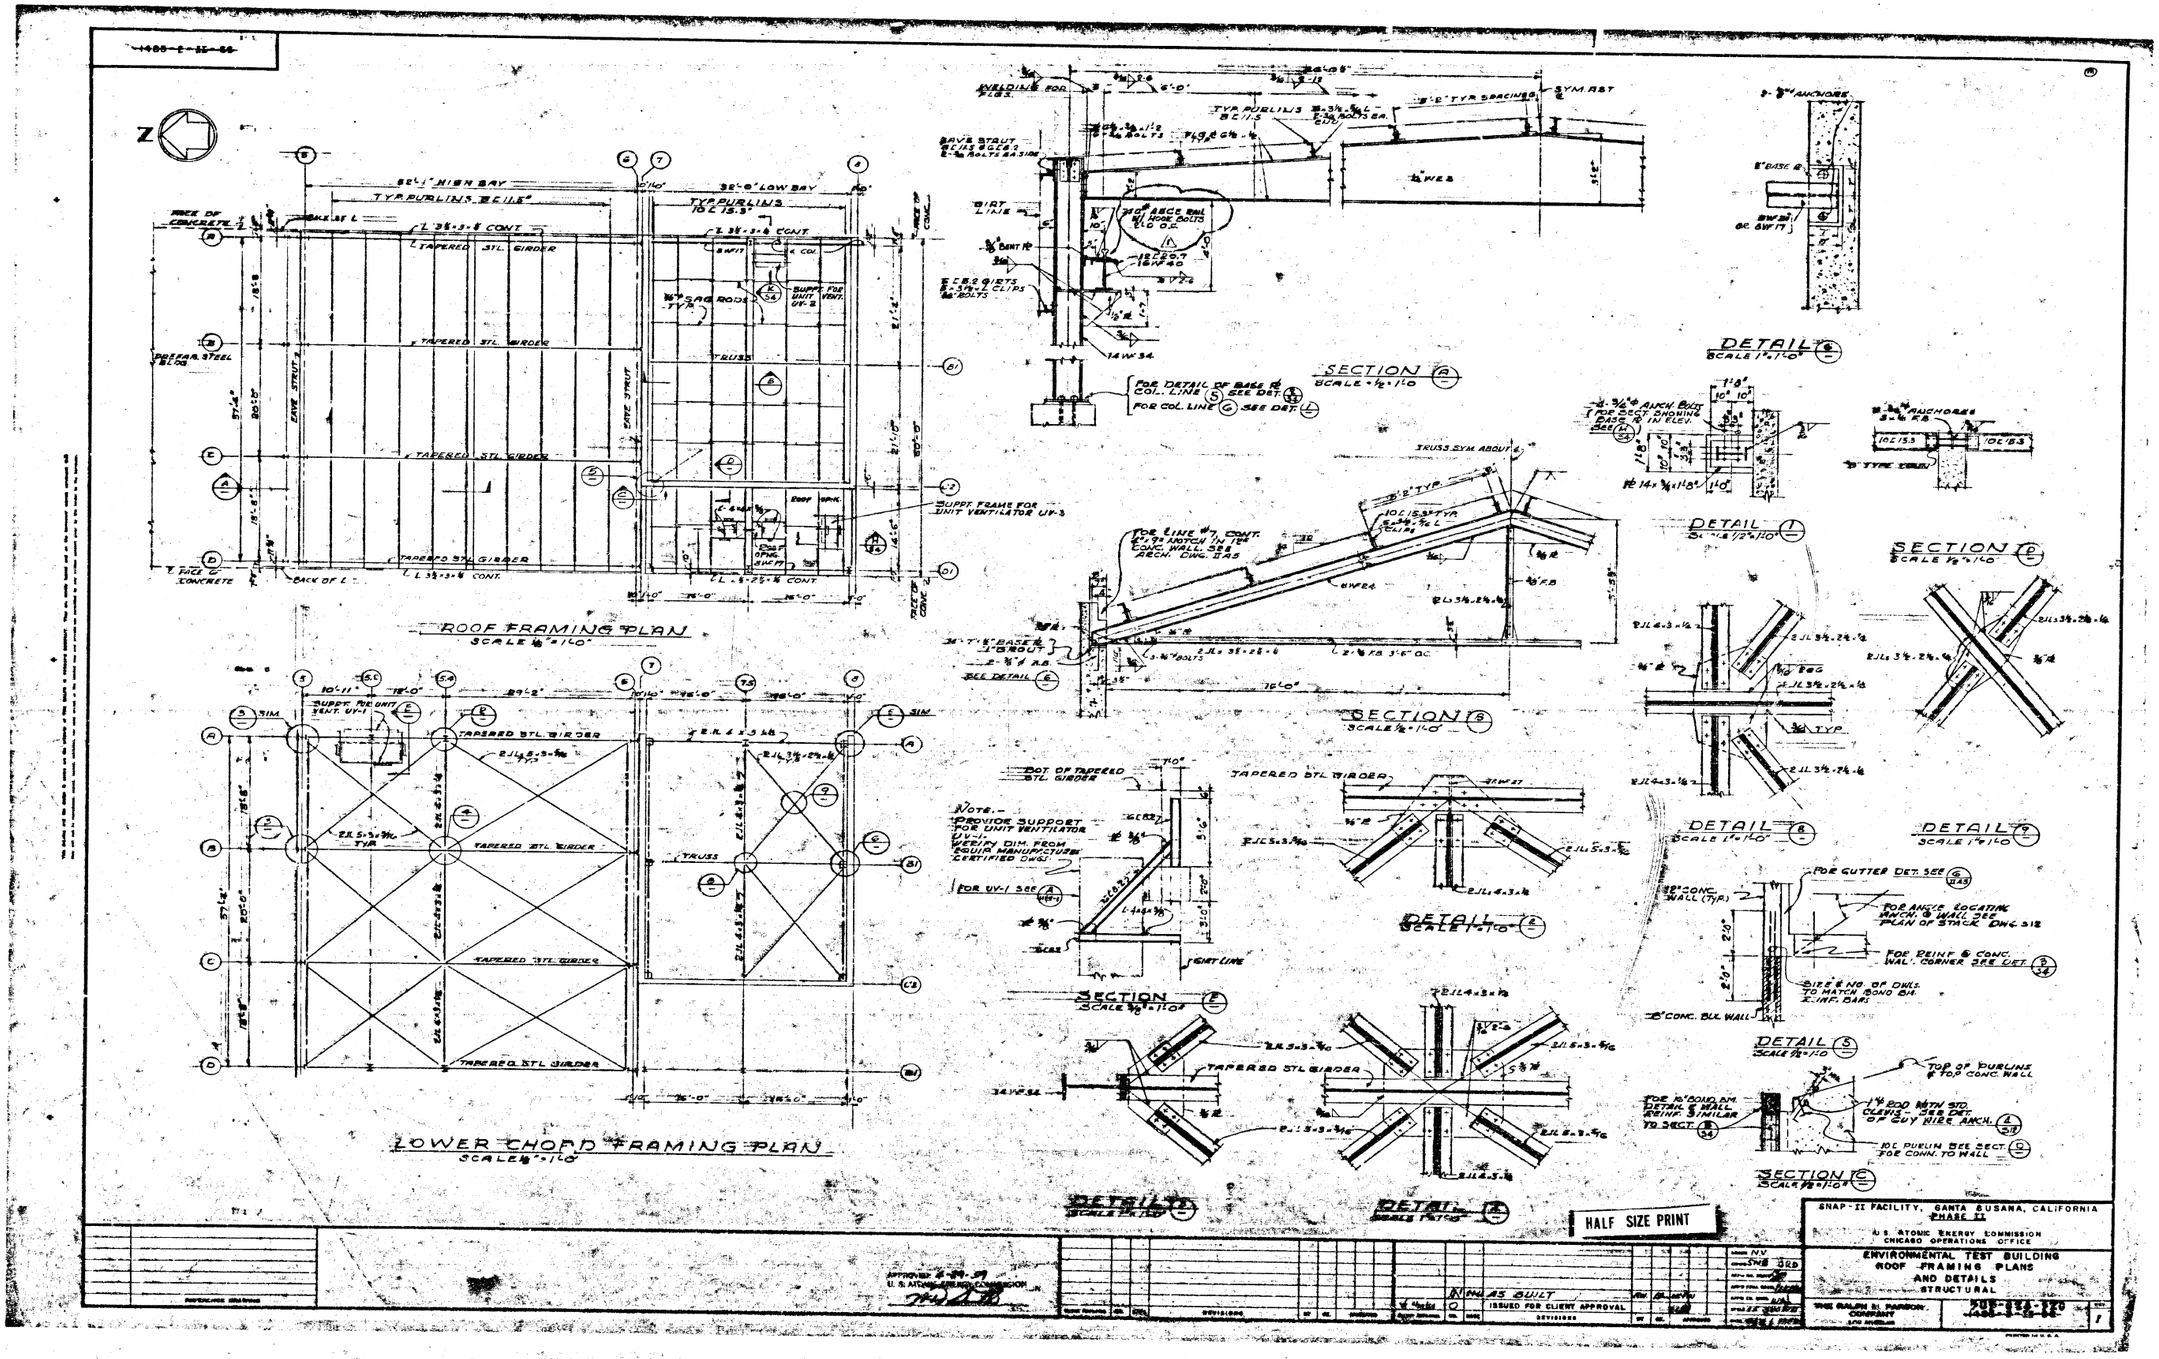
ROOF FRAMING PLAN
SCALE 1/8" = 1'-0"
LOWER CHORD FRAMING PLAN
SCALE 1/8" = 1'-0"
SECTION A
SCALE 1/2" = 1'-0"
SECTION B
SCALE 1/2" = 1'-0"
SECTION C
SCALE 1/2" = 1'-0"
SECTION D
SCALE 1/2" = 1'-0"
SECTION E
SCALE 1/2" = 1'-0"
HALF SIZE PRINT
SNAP-II FACILITY, SANTA SUSANA, CALIFORNIA
PHASE II
U.S. ATOMIC ENERGY COMMISSION
CHICAGO OPERATIONS OFFICE
ENVIRONMENTAL TEST BUILDING
ROOF FRAMING PLANS
AND DETAILS
STRUCTURAL
THE RALPH M. PARSONS COMPANY
LOS ANGELES
ISSUED FOR CLIENT APPROVAL
AS BUILT