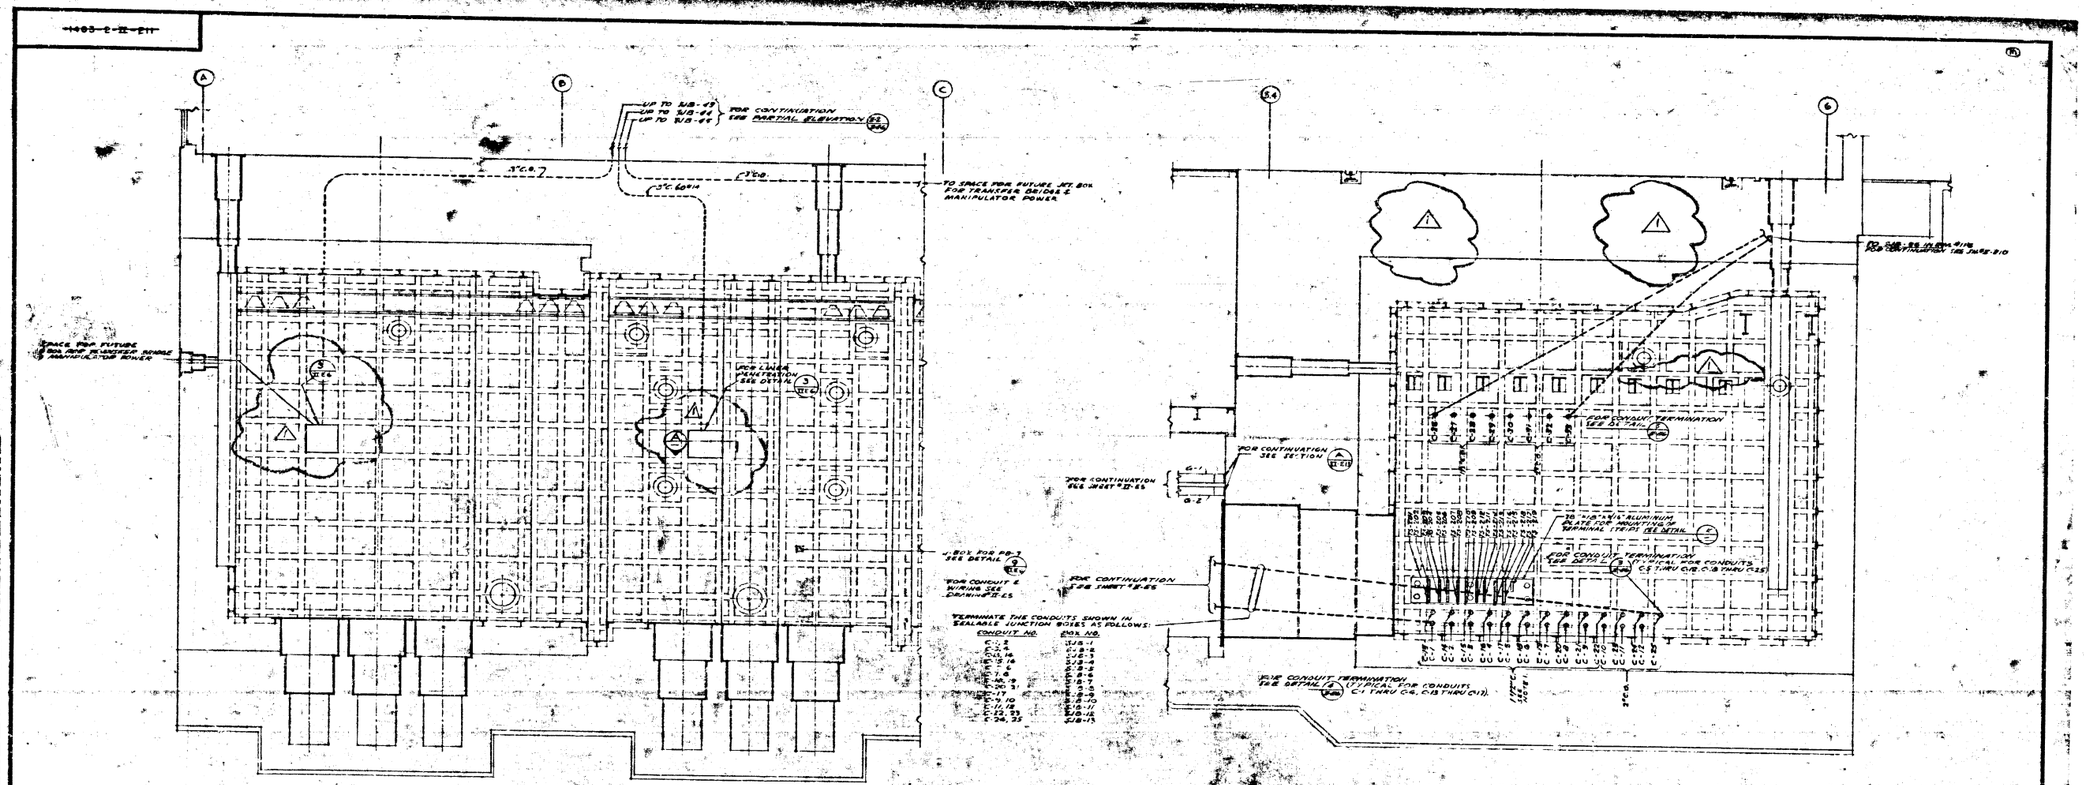

SECTION (C)
SCALE: 3/8" = 1'-0"

SECTION (D)
SCALE: 3/8" = 1'-0"

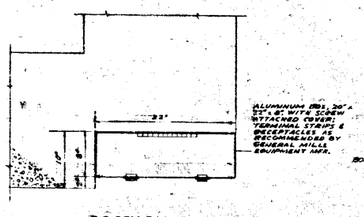

SECTION (A)
SCALE: 1½" = 1'-0"

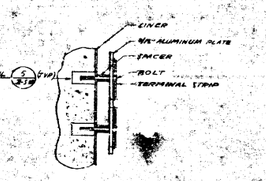

DETAIL (K)
SCALE: NONE

BOX NO.	DETAIL NO. SH. E-26	TYPE	DIMENSIONS W	H	D
SJB-1					
TMBU-1,2	6	1	8	8	6
SJB-14,15	7	2	18	24	10
SJB-16	7	2	8	6	6
SJB-17,18	7	2	18	24	10
SJB-13	7	2	8	6	6
SJB-30					
TMBU-3	6	1	8	8	6
SJB-33					
TMBU-7,8	7	2	18	12	8
SJB-27,28	6	3	6	5	6
SJB-31,32	7	3			6
SJB-7,8, 9,10,11	7	3	18	14	6
SJB-23, 24,25	7	3	8	6	6
SJB-19 TMBU-5	7	2	4	4	4

SEALABLE JUNCTION BOX SCHEDULE

NOTES:

1. FOR CONDUIT [illegible] SHOWN ON THE [illegible] ENGINE, BOILER, THE [illegible] THERMOCOUPLE WIRING SCHEMATIC DRAWING [illegible] EQUIPMENT & CONDUITS NOT SCHEDULED [illegible]
2. FOR GENERAL NOTES, LIST OF SYMBOLS AND ABBREVIATIONS SEE SH. E-1.

HALF SIZE PRINT

SNAP-II FACILITY, SANTA SUSANA, CALIFORNIA
PHASE II
U.S. ATOMIC ENERGY COMMISSION
CHICAGO OPERATIONS OFFICE

ENVIRONMENTAL TEST BUILDING
VAULT SECTIONS I
ELECTRICAL

THE RALPH M. PARSONS COMPANY
LOS ANGELES

205-0124-322

REV. 2

ISSUED FOR CLIENT APPROVAL

AS BUILT

APPROVED 5-1-69
U.S. ATOMIC ENERGY COMMISSION