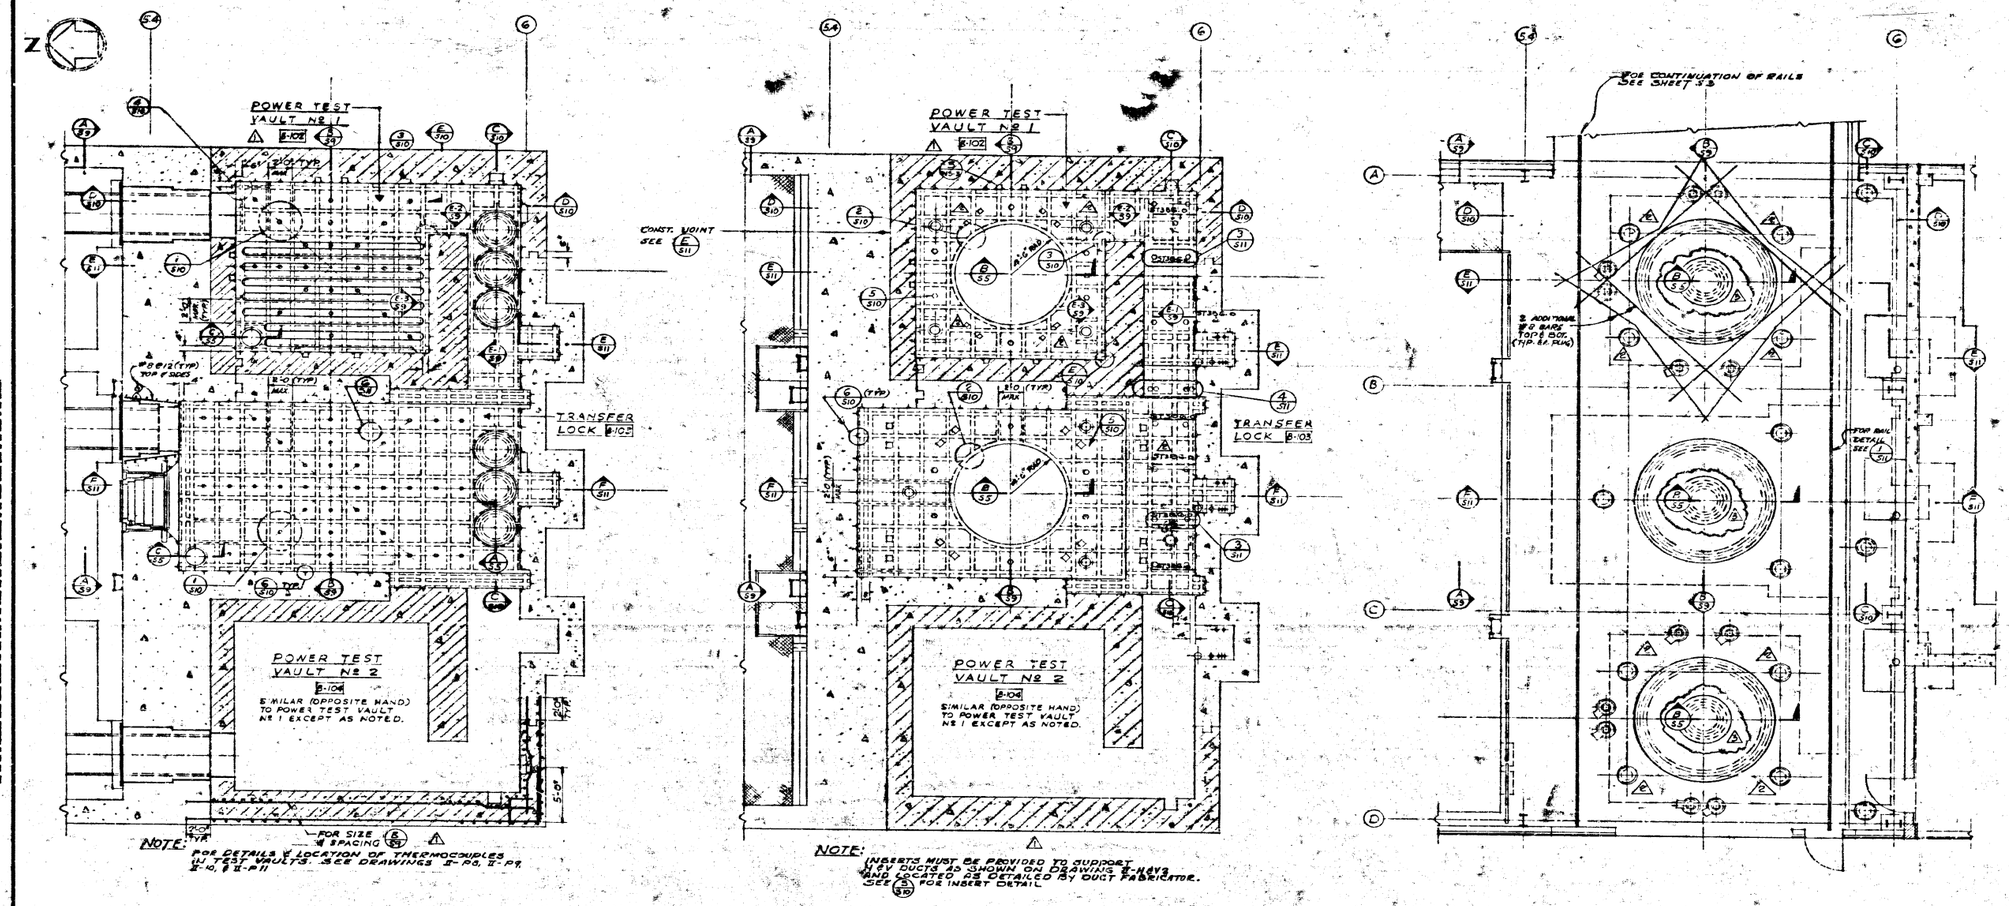

BASEMENT PLAN

PLAN AT CEILING

FIRST FLOOR PLAN

ENLARGED PLANS OF VAULT COMPLEX AREA

SCALE: 1/4" = 1'-0"

GENERAL NOTES

ALL TEES SHALL BE SPACED 2'-0 O.C. UNLESS NOTED OTHERWISE

FOR DIMENSIONS NOT SHOWN SEE DWGS. S1, A8, A9, A10, & A11

ALL DIMENSIONS INSIDE VAULT COMPLEX ARE TO FACE OF CONCRETE. (BACK OF ALUMINUM LINER)

HALF SIZE PRINT

SNAP-II FACILITY, SANTA SUSANA, CALIFORNIA
PHASE II
U.S. ATOMIC ENERGY COMMISSION
CHICAGO OPERATIONS OFFICE

ENVIRONMENTAL TEST BUILDING
POWER VAULT AND
TRANSFER LOCK LINER DETAILS 3
STRUCTURAL

THE RALPH M. PARSONS COMPANY
LOS ANGELES

ISSUED FOR CLIENT APPROVAL

AS BUILT