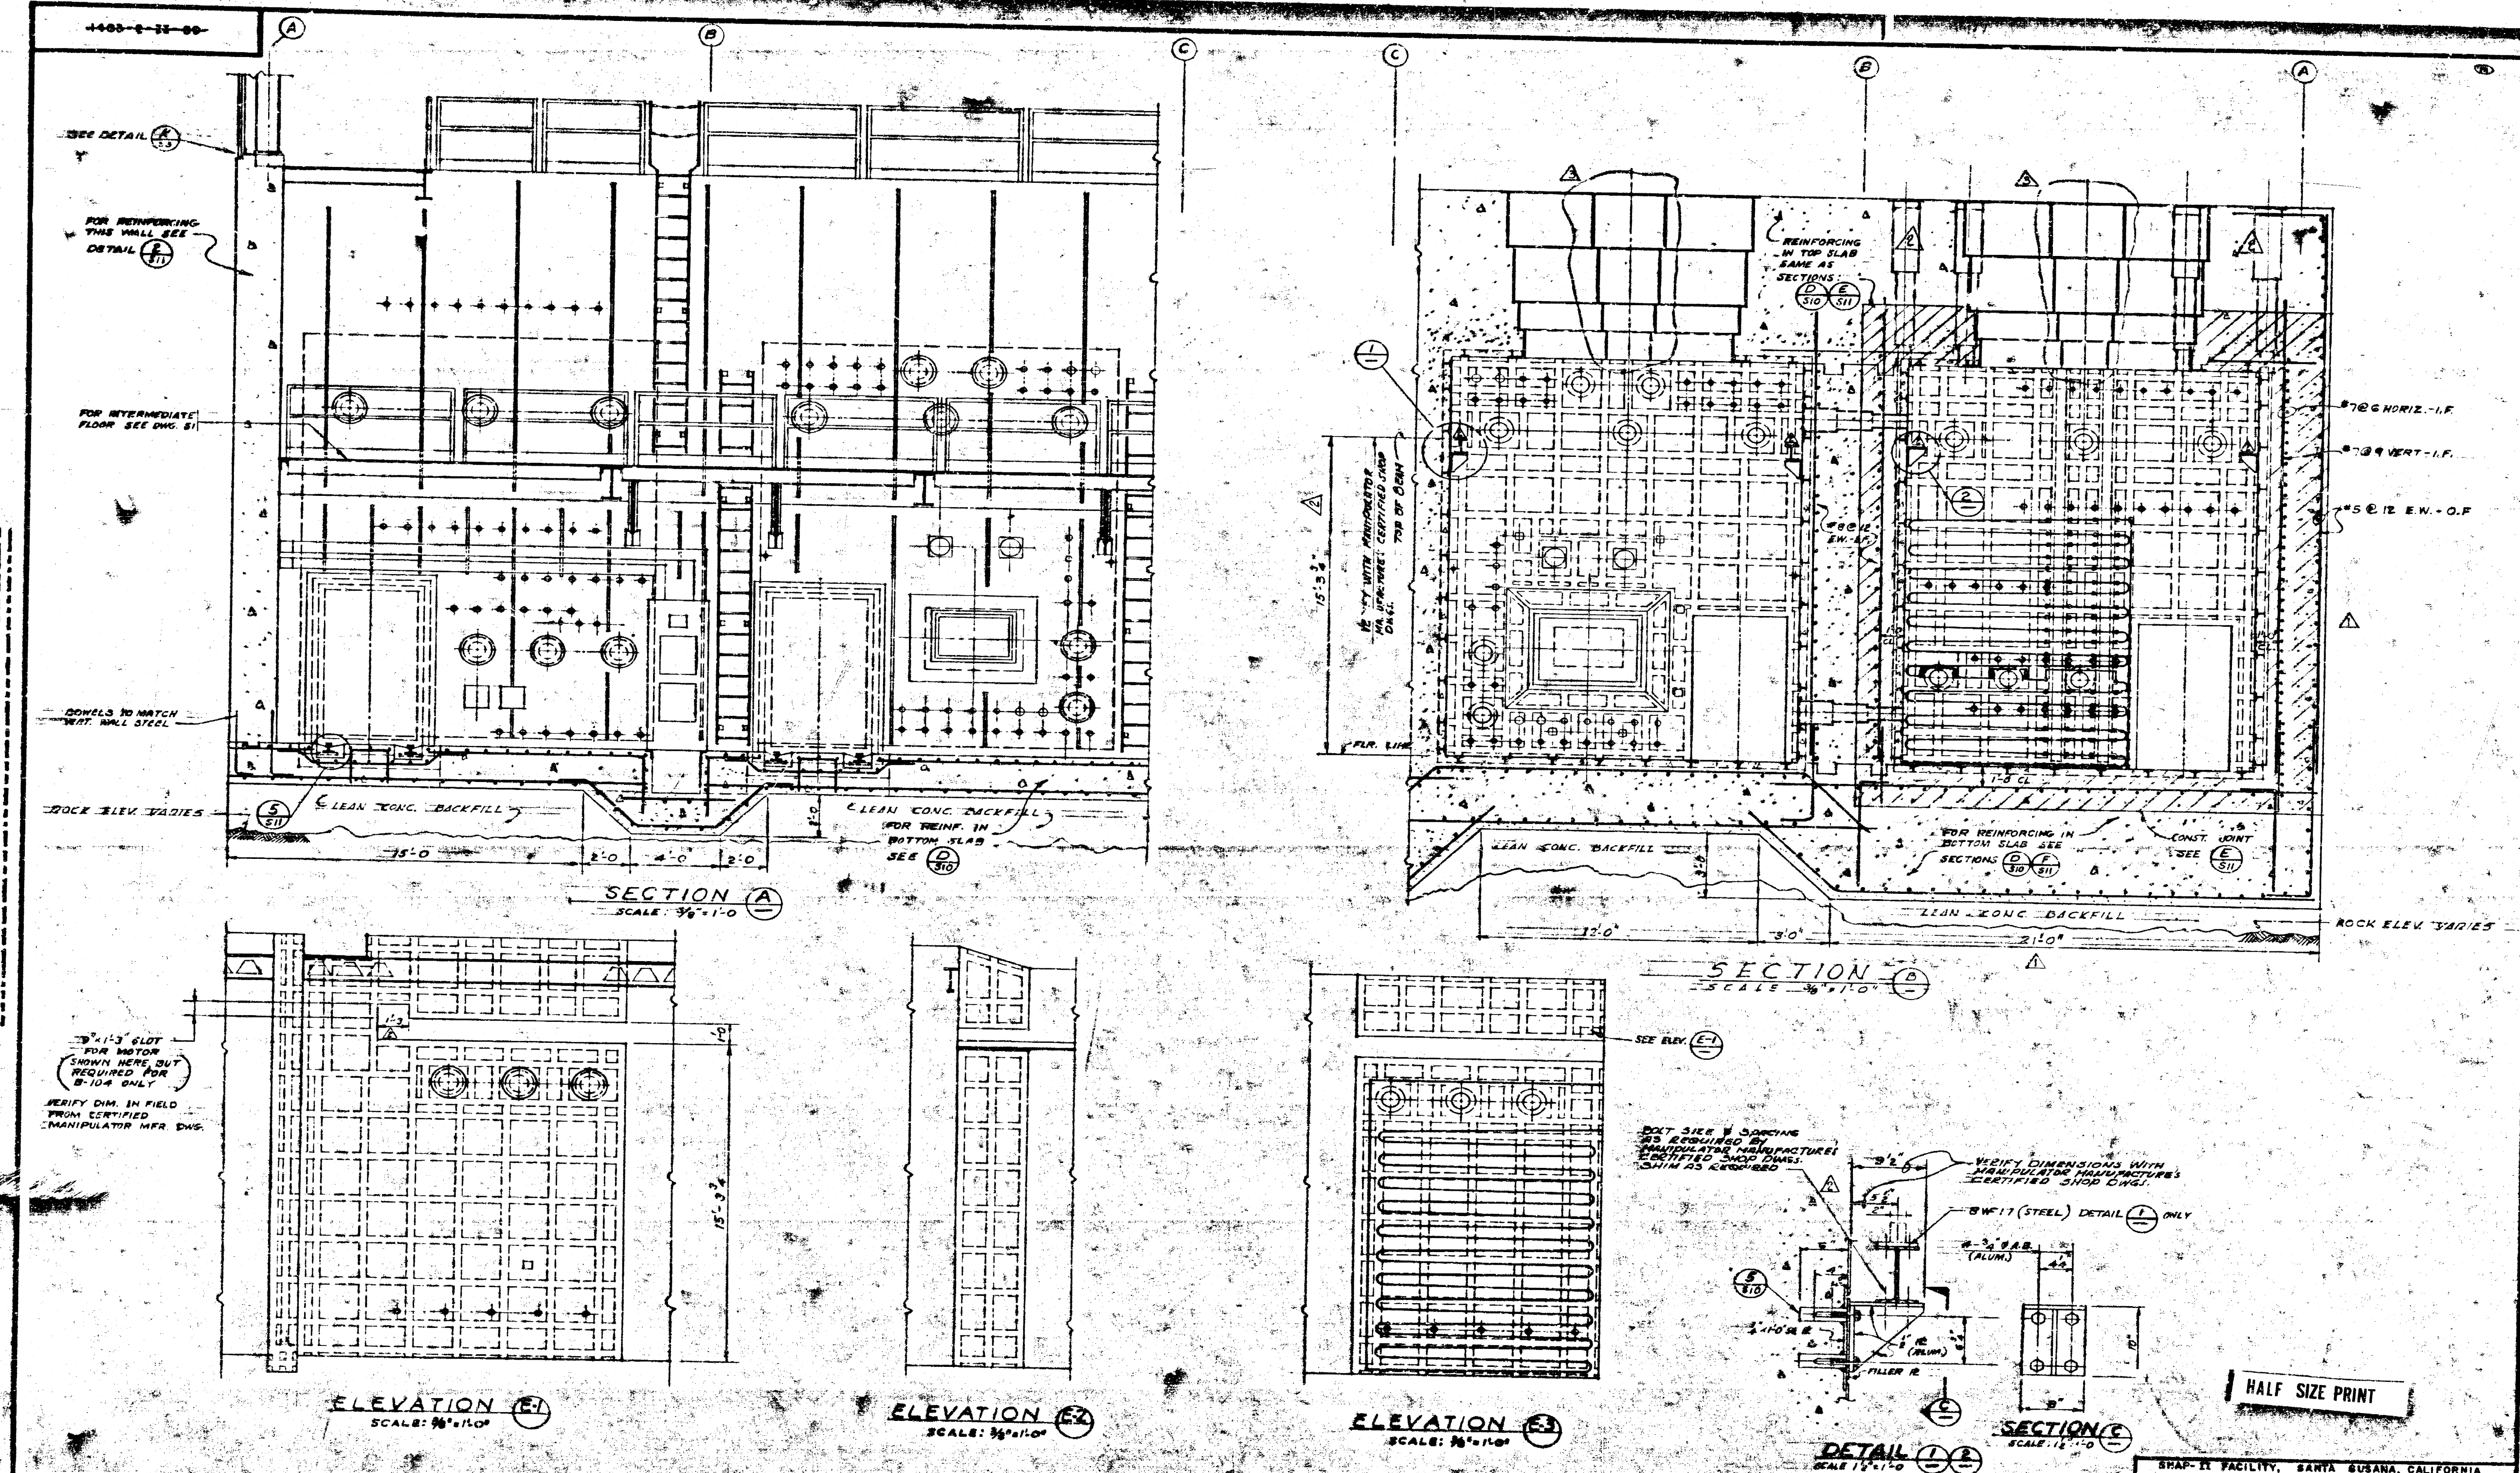

HALF SIZE PRINT

APPROVED: U. S. ATOMIC ENERGY COMMISSION

AS BUILT

ISSUED FOR CLIENT APPROVAL

SNAP-II FACILITY, SANTA SUSANA, CALIFORNIA
PHASE II

U.S. ATOMIC ENERGY COMMISSION
CHICAGO OPERATIONS OFFICE

ENVIRONMENTAL TEST BUILDING
POWER VAULT AND
TRANSFER LOCK LINER DETAILS II
STRUCTURAL

THE RALPH M. PARSONS COMPANY
LOS ANGELES

585-024-S27

1403-2-33-80