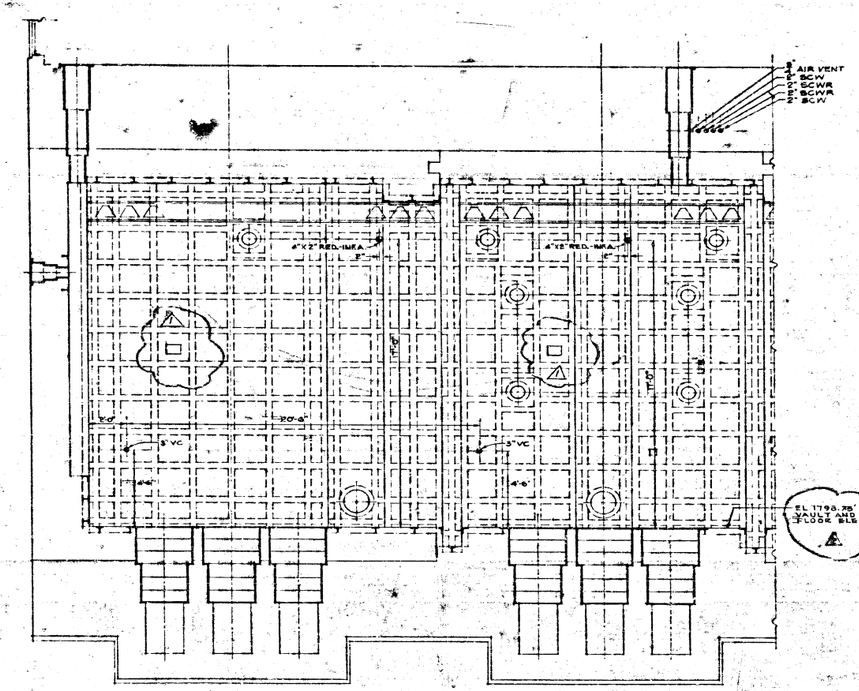

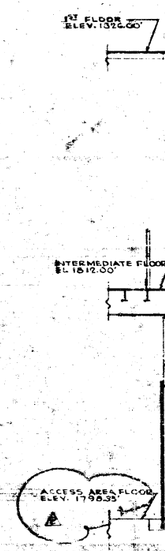

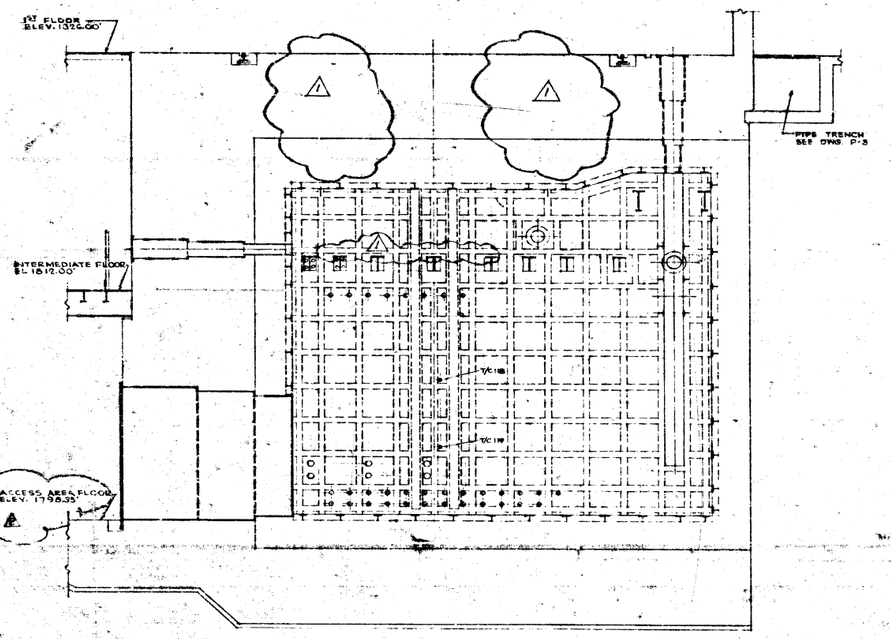

SECTION (D)
SCALE: 3/8" = 1'-0"

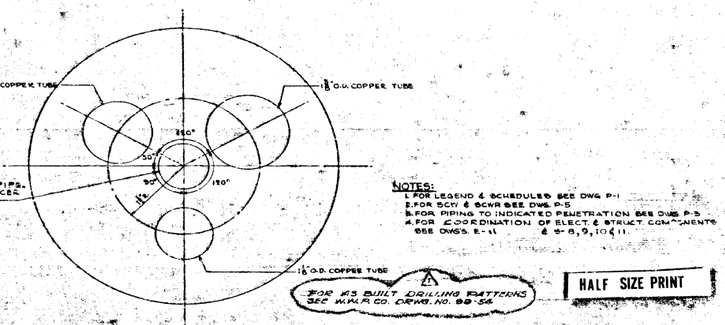

NOTES:
1. FOR LEGEND & SCHEDULES SEE DWG P-1
2. FOR SCW & SCWR SEE DWG P-5
3. FOR PIPING TO INDICATED PENETRATION SEE DWG P-3
4. FOR COORDINATION OF ELECT. & STRUCT. COMMENTS SEE DWGS. E-11 & S-8, 9, 10 & 11.

(A) FOR AS BUILT DRILLING PATTERNS SEE W.M.P.A. CO. DRWG. NO. 99-56

HALF SIZE PRINT

SECTION (C)
SCALE: 3/8" = 1'-0"

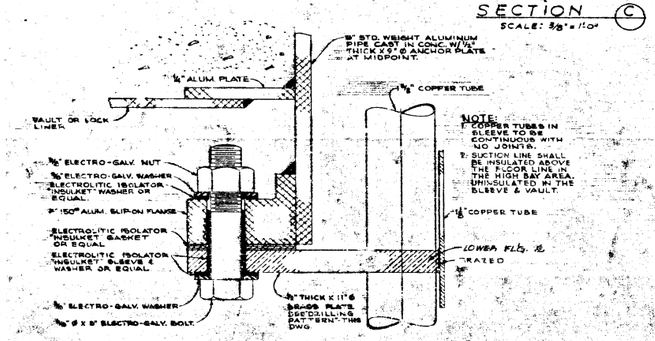

NOTE:
1. COPPER TUBES IN SLEEVE TO BE CONTINUOUS WITH NO JOINTS.
2. SUCTION LINE SHALL BE INSULATED ABOVE THE FLOOR LINE IN THE HIGH BAY AREA. UNINSULATED IN THE SLEEVE & VAULT.

DETAIL (1)
NO SCALE

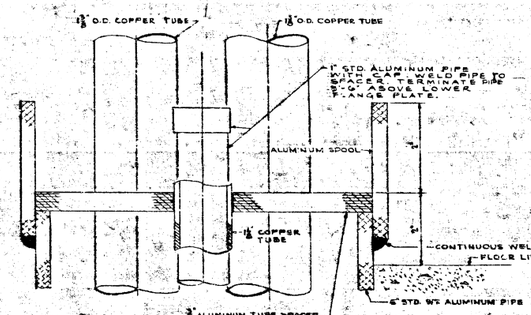

DETAIL (2)
NO SCALE

DRILLING PATTERN FOR BRASS PLATE & ALUMINUM SPACER
NO SCALE

		AS BUILT	
	A	ISSUE FOR CLIENT APPROVAL	
	0		
REVISIONS			

APPROVED U.S. ATOMIC ENERGY COMMISSION

SNAP-II FACILITY, SANTA SUSANA, CALIFORNIA
PHASE IV
U.S. ATOMIC ENERGY COMMISSION
CHICAGO OPERATIONS OFFICE

ENVIRONMENTAL TEST BUILDING
VAULT COMPLEX AREA - SECTIONS
SHIELD COOLING WATER
PIP NO

THE RALPH M. PARSONS COMPANY
LOS ANGELES

NAVY-SNA-PIP
-683-2-11-P10

1 2