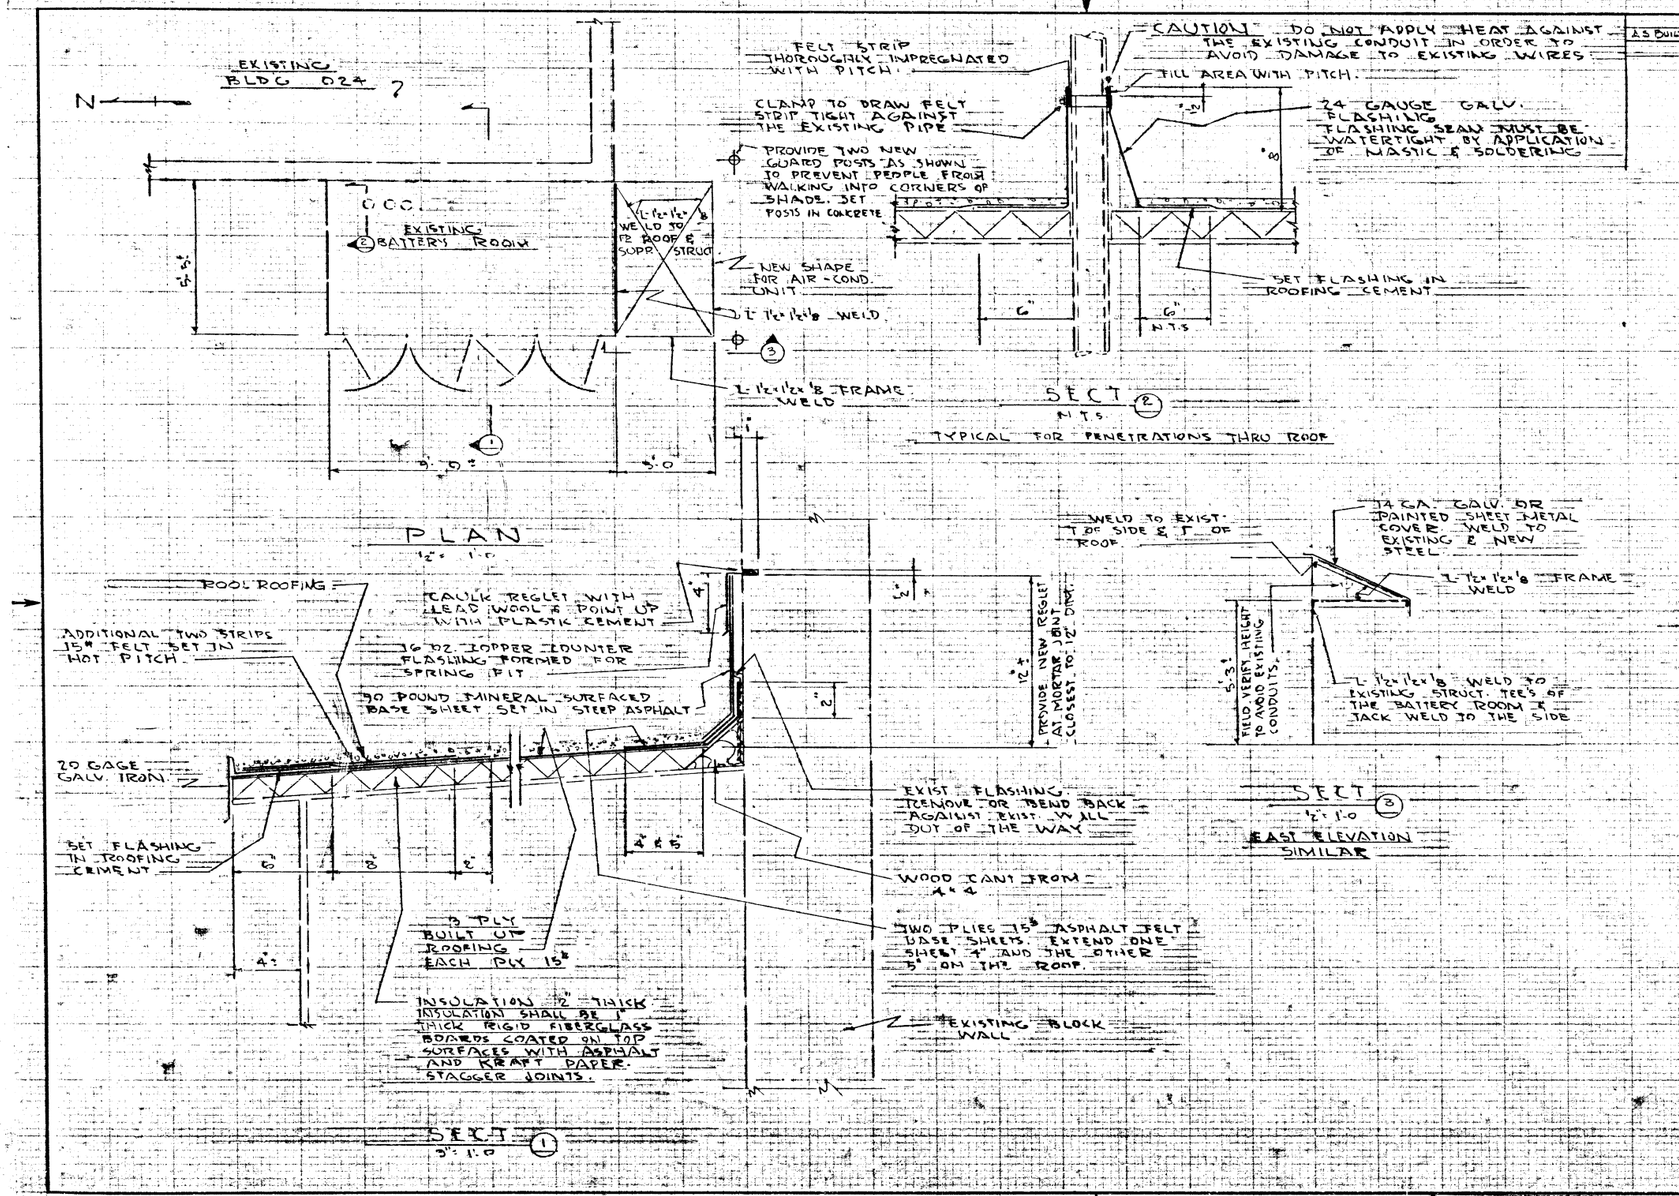

REVISIONS				
AS BUILT	SYM	DESCRIPTION	DATE	APPROVED
	E	AS BUILT RECORDED PEWR# 71607	2-13-63	R.EWNI

NOTES

1. PAINT ALL EXPOSED METAL, EXCEPT GALVANIZED, WITH TWO COATS OF HEAVY DUTY ENAMEL IN ADDITION TO THE SHOP COAT. COLOR SHALL BE DARK BEIGE COLOR CODE 3-F6 AS GIVEN BY THE CONTAINER CORP OF AMERICAS, 3RD EDITION.

PEWR 71607

ATOMICS INTERNATIONAL
A DIVISION OF NORTH AMERICAN AVIATION, INC.
8900 DESOTO AVENUE, CANOGA PARK, CALIF.

SANTA SUSANA FACILITY – BLD'G 024
BATTERY ROOM COOLING
ROOFING & AIR CONDITIONER COVER

DRAWN	M. S.	11-64	DWG. SIZE D	303-024-546
CHECKED				
ENGINEER	[illegible]	11-64	SCALE NOTED	
APPROVED	[illegible]	1/2		SHEET NO. ___ OF ___

REDUCED DRAWING