REVISIONS				
AS BUILT	SYM	DESCRIPTION	DATE	APPROVED
	1	EXCHANGE CONTROL SCHEME	5-19-64	[illegible]
	2	MODIFY CONTROL CKT. TO DELAY OPENING OF CONTACTOR MM ON FAILURE OF COMMERCIAL POWER SUPPLY	5/20/64	[illegible]
	3	REPLACE MAGNETICALLY HELD TRANSFER SWITCH WITH MECH. HELD, BUL. ASCO BUL 917-375 TYPE 550-3	7/9/64	[illegible]
10/5/64 W.J.	4	REMOVE ASCO TRANSFER SW. & REINSTALL SQUARE D BUL 8702 SW., PER WR 124 72078	10/21/64	[illegible]

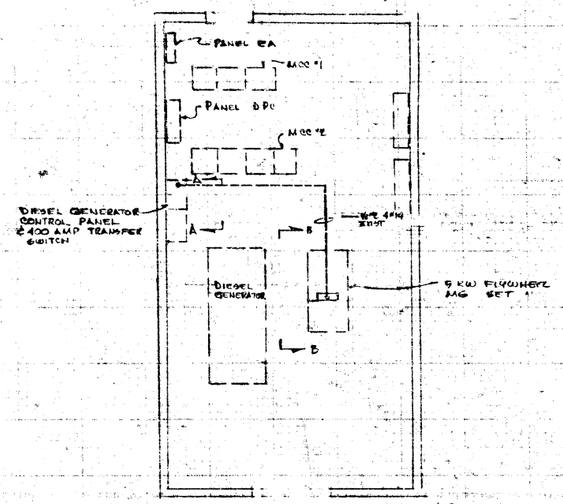

ROOM #115 - PLAN

SCALE 1/2"=1'-0"

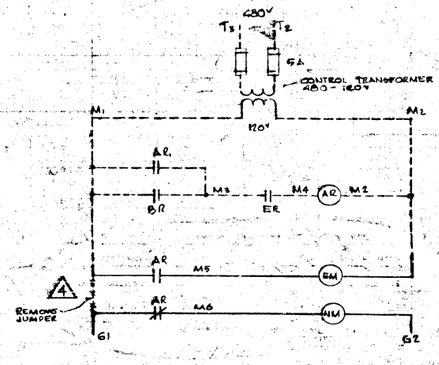

SCHEMATIC DIAGRAM

WIRING SHOWN WITH BROKEN LINES IS EXIST

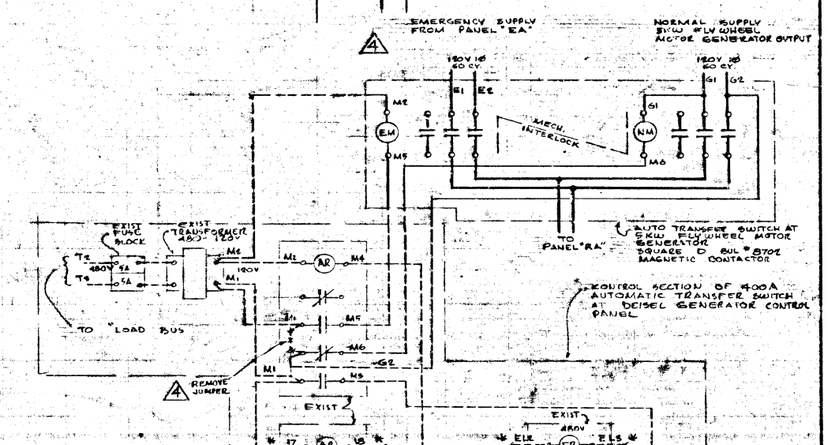

WIRING DIAGRAM

WIRING SHOWN WITH BROKEN LINES IS EXISTING WIRING SHOWN WITH SOLID LINES IS NEW
MODIFIES LAKE SHORE ELEC CO DWG NO C 61-34-C1
* SEE LAKE SHORE DWG # C 61-34-C1 FOR CONTINUATION

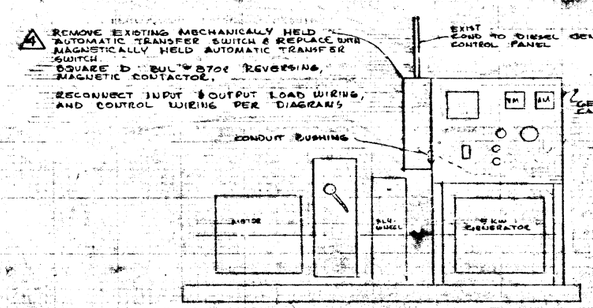

ELEVATION B-B

NO SCALE

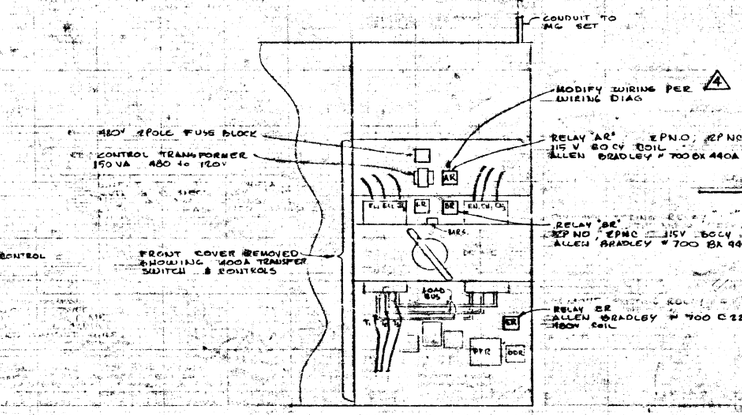

ELEVATION A-A

NO SCALE

REDUCED DRAWING

PEUR 70226
TWR 57057

NOTICE

THIS DRAWING INVOLVES CONFIDENTIAL PROPRIETARY DESIGN INFORMATION OF ATOMICS INTERNATIONAL, A DIVISION OF NORTH AMERICAN AVIATION, INC. AND ALL RIGHTS ARE EXPRESSLY RESERVED. IT IS SUBMITTED UNDER A TRUST RELATIONSHIP FOR A SPECIFIED PURPOSE. IT IS AGREED THAT IT WILL NOT BE USED FOR ANY OTHER PURPOSE NOR ITS CONTENTS REVEALED TO ANYONE EXCEPT FOR THAT PURPOSE, NOR COPIED IN WHOLE OR IN PART, NOR ITS KNOWN FEATURES USED IN OTHER PROJECTS. IT WILL BE RETURNED TO ATOMICS INTERNATIONAL WHEN NO LONGER REQUIRED OR UPON REQUEST.

ATOMICS INTERNATIONAL
A DIVISION OF NORTH AMERICAN AVIATION, INC.
8900 DESOTO AVENUE, CANOGA PARK, CALIF.

SANTA SUSANA FACILITY BLDG 024
LOW BAY MODIFICATIONS
5 KW M.G. SET MODIFICATION

DRAWN	[illegible]	DWG SIZE	D
CHECKED		SCALE	1/4"=1'
ENGINEER	[illegible]		
APPROVED	[illegible]		

303 024 E 56

SHEET NO [illegible] OF [illegible]

FORM 1004-2 REV. 1-65