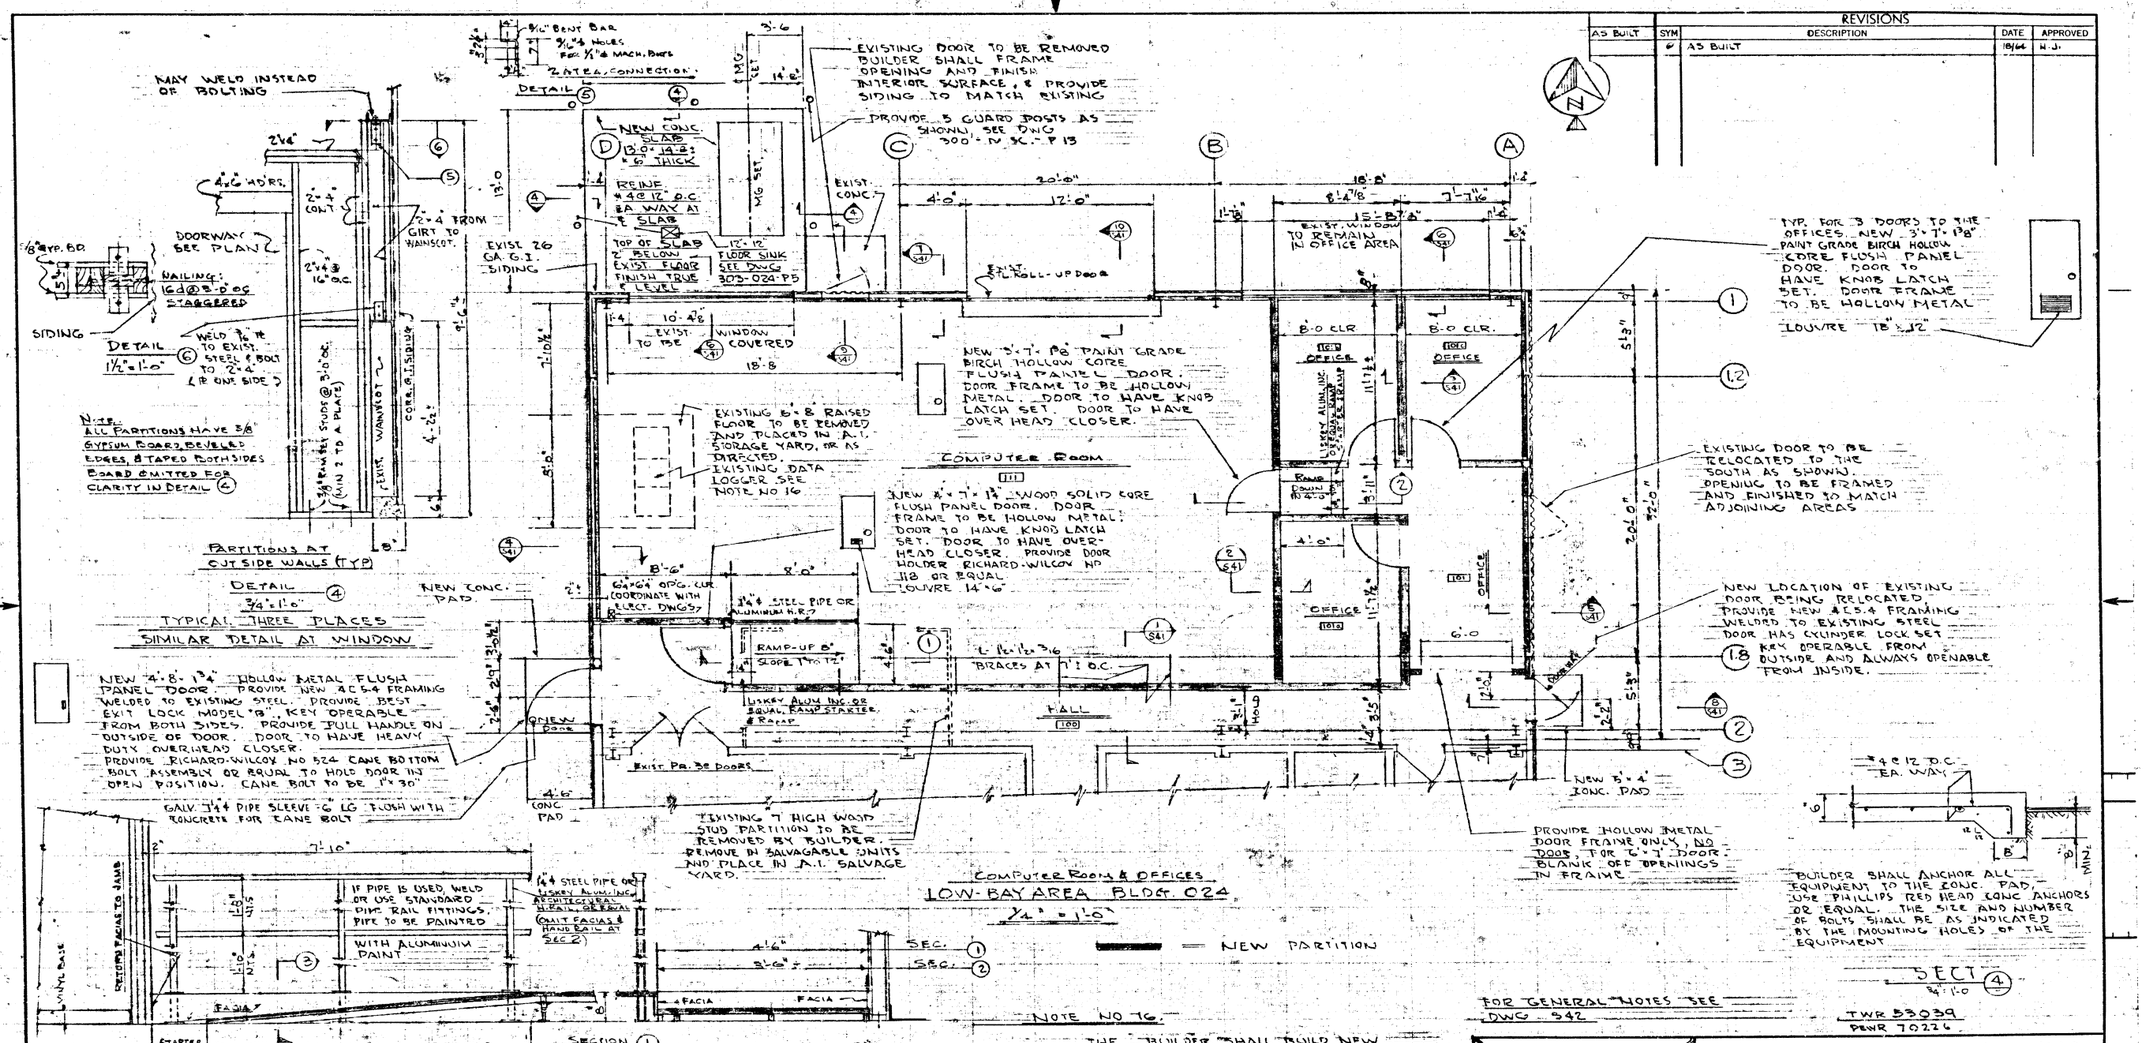REVISIONS				
AS BUILT	SYM	DESCRIPTION	DATE	APPROVED
	6	AS BUILT	10/66	W.J.