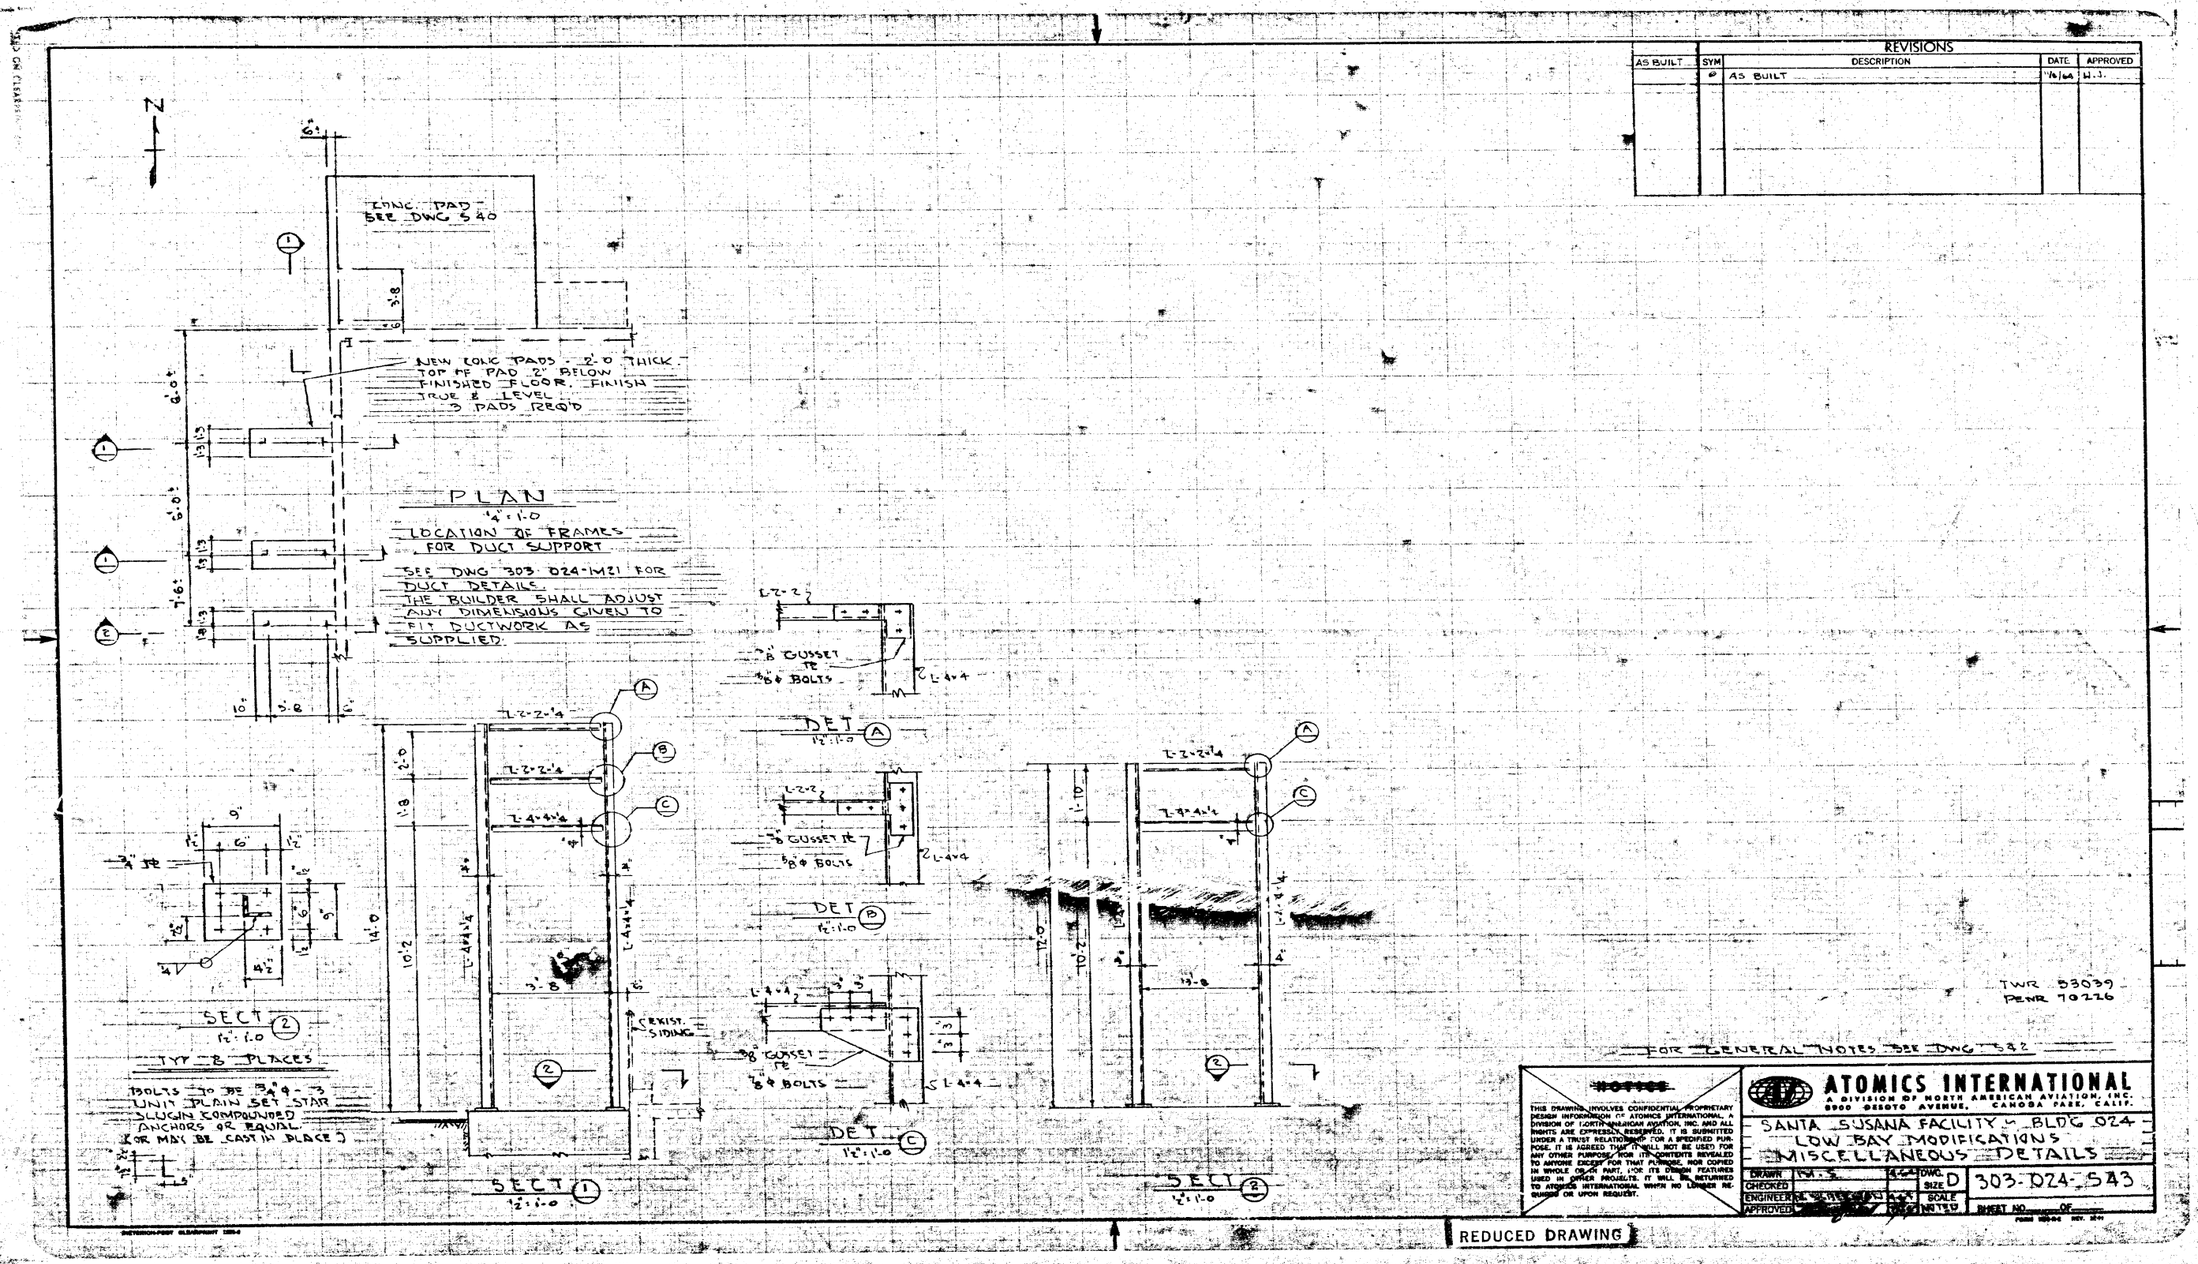

REVISIONS				
AS BUILT	SYM	DESCRIPTION	DATE	APPROVED
	0	AS BUILT	11/6/64	H.J.

TWR 53039
PENR 70226

FOR GENERAL NOTES SEE DWG S42

~~NOTICE~~

THIS DRAWING INVOLVES CONFIDENTIAL PROPRIETARY DESIGN INFORMATION OF ATOMICS INTERNATIONAL, A DIVISION OF NORTH AMERICAN AVIATION, INC. AND ALL RIGHTS ARE EXPRESSLY RESERVED. IT IS SUBMITTED UNDER A TRUST RELATIONSHIP FOR A SPECIFIED PURPOSE. IT IS AGREED THAT IT WILL NOT BE USED FOR ANY OTHER PURPOSE, NOR ITS CONTENTS REVEALED TO ANYONE EXCEPT FOR THAT PURPOSE, NOR COPIED IN WHOLE OR IN PART, NOR ITS DESIGN FEATURES USED IN OTHER PROJECTS. IT WILL BE RETURNED TO ATOMICS INTERNATIONAL WHEN NO LONGER REQUIRED OR UPON REQUEST.

ATOMICS INTERNATIONAL
A DIVISION OF NORTH AMERICAN AVIATION, INC.
8900 DESOTO AVENUE, CANOGA PARK, CALIF.

SANTA SUSANA FACILITY - BLDG 024
LOW BAY MODIFICATIONS
MISCELLANEOUS DETAILS

DRAWN	M.S.	DWG. SIZE D	303-024-S43
CHECKED			
ENGINEER	[illegible]	SCALE NOTED	
APPROVED	[illegible]		SHEET NO. ___ OF ___

REDUCED DRAWING