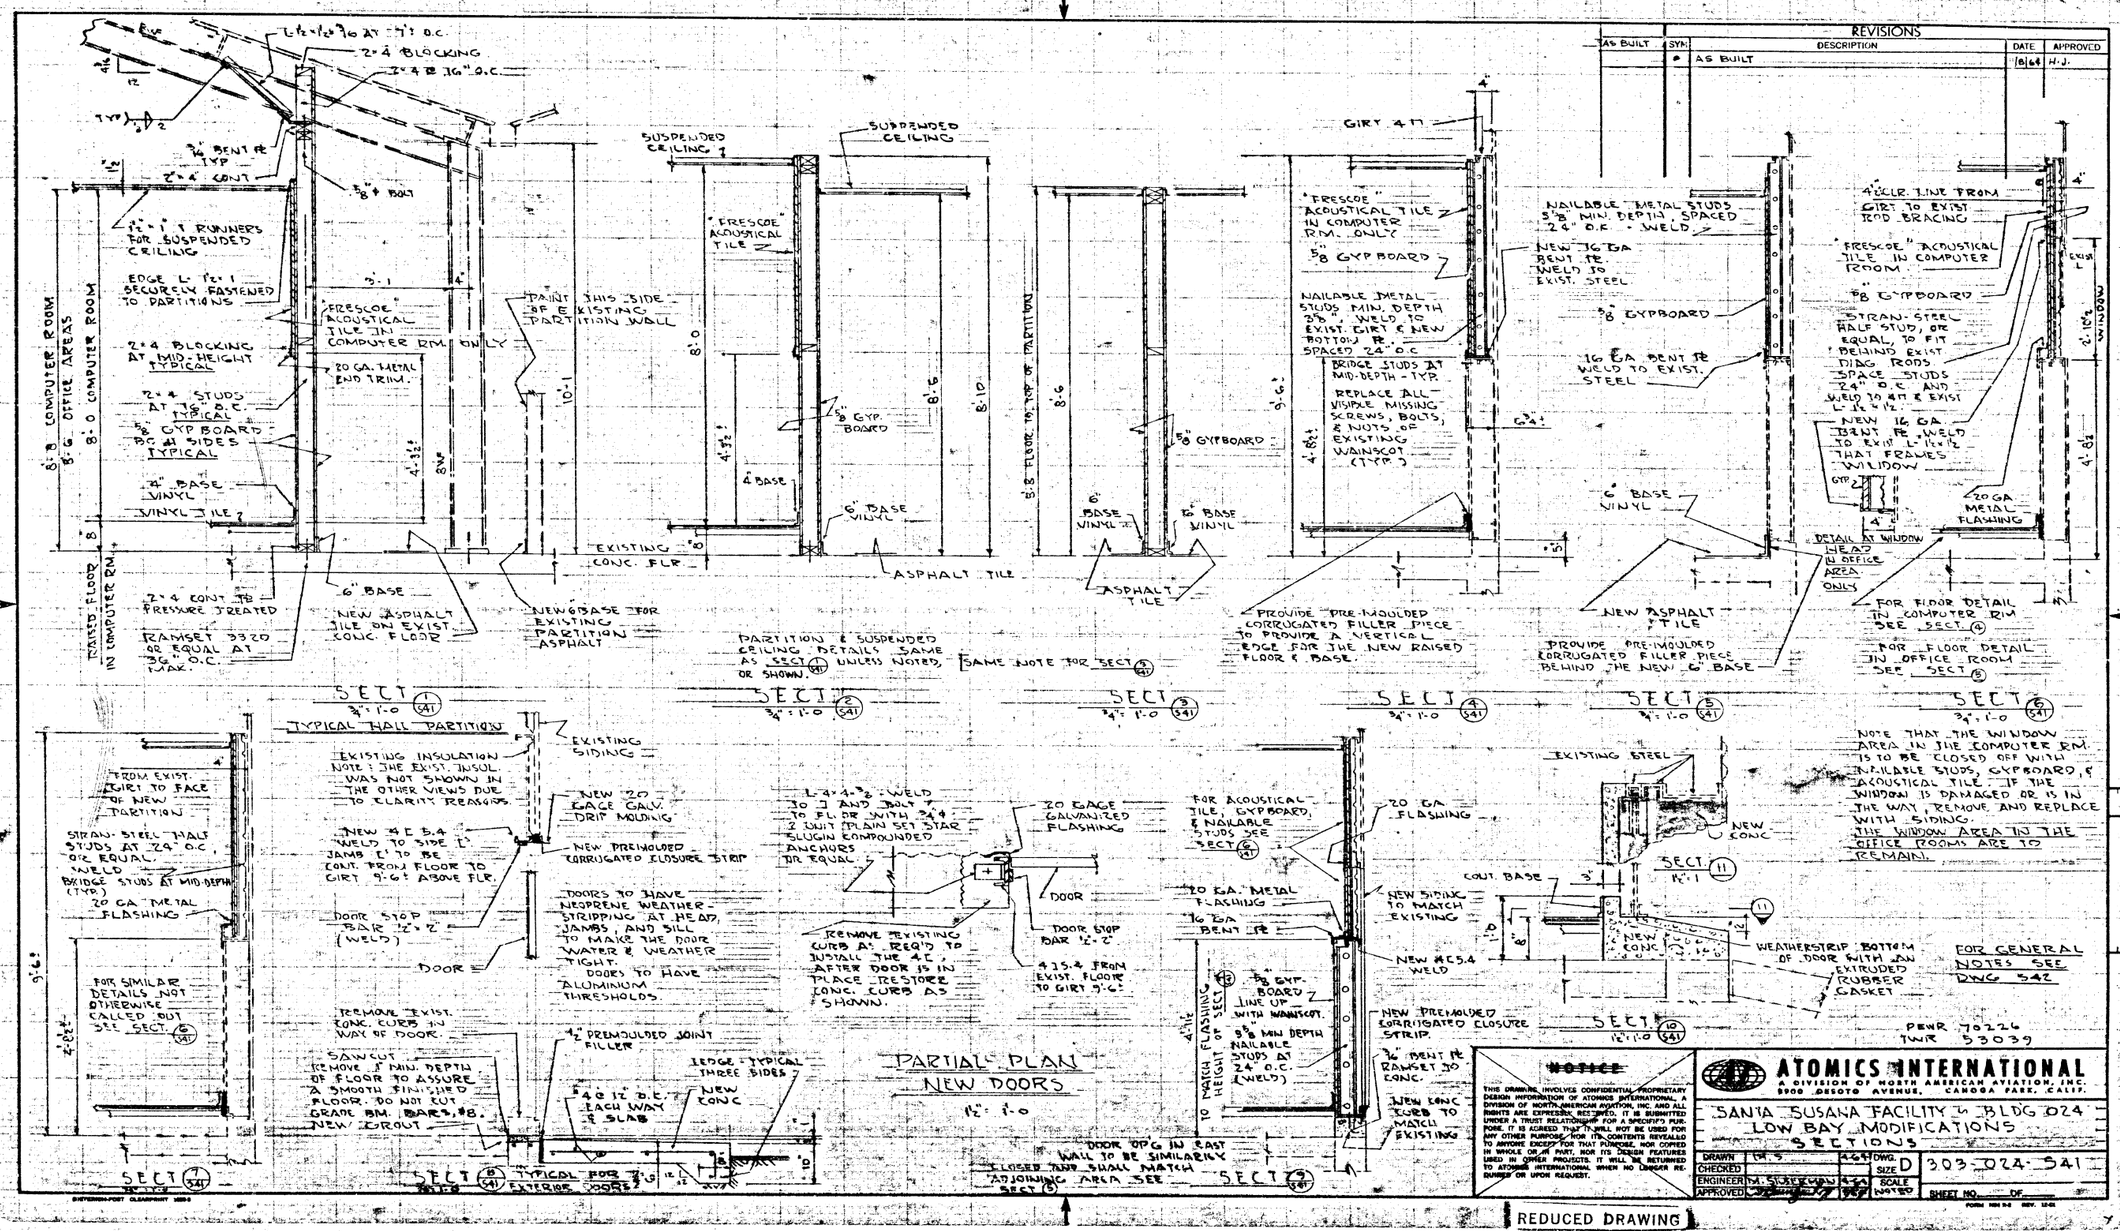REVISIONS				
AS BUILT	SYM	DESCRIPTION	DATE	APPROVED
	•	AS BUILT	8/64	H.J.