X-220-A-6001-E

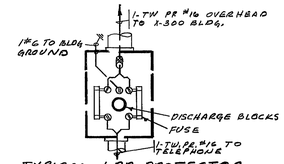

TYPICAL 1 PR PROTECTOR CABINET-WIRING DIAGRAM
(B/M X-300-E-41 ITEM # 23)

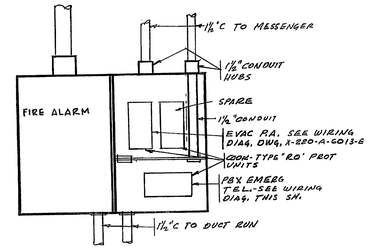

DETAIL "A"
POLE # 543 PROTECTOR CAB.
SCALE 1 1/2" = 1'-0"
SEE A.M. KINNEY DWG. # X-215-B-104-E FOR COMPLETE DETAIL OF PROT. CAB & MOUNTING

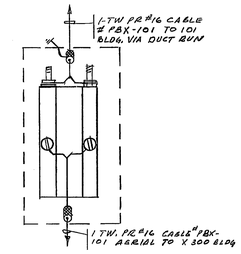

COOK CO. TYPE "RO" PROTECTOR UNIT WIRING DIAGRAM

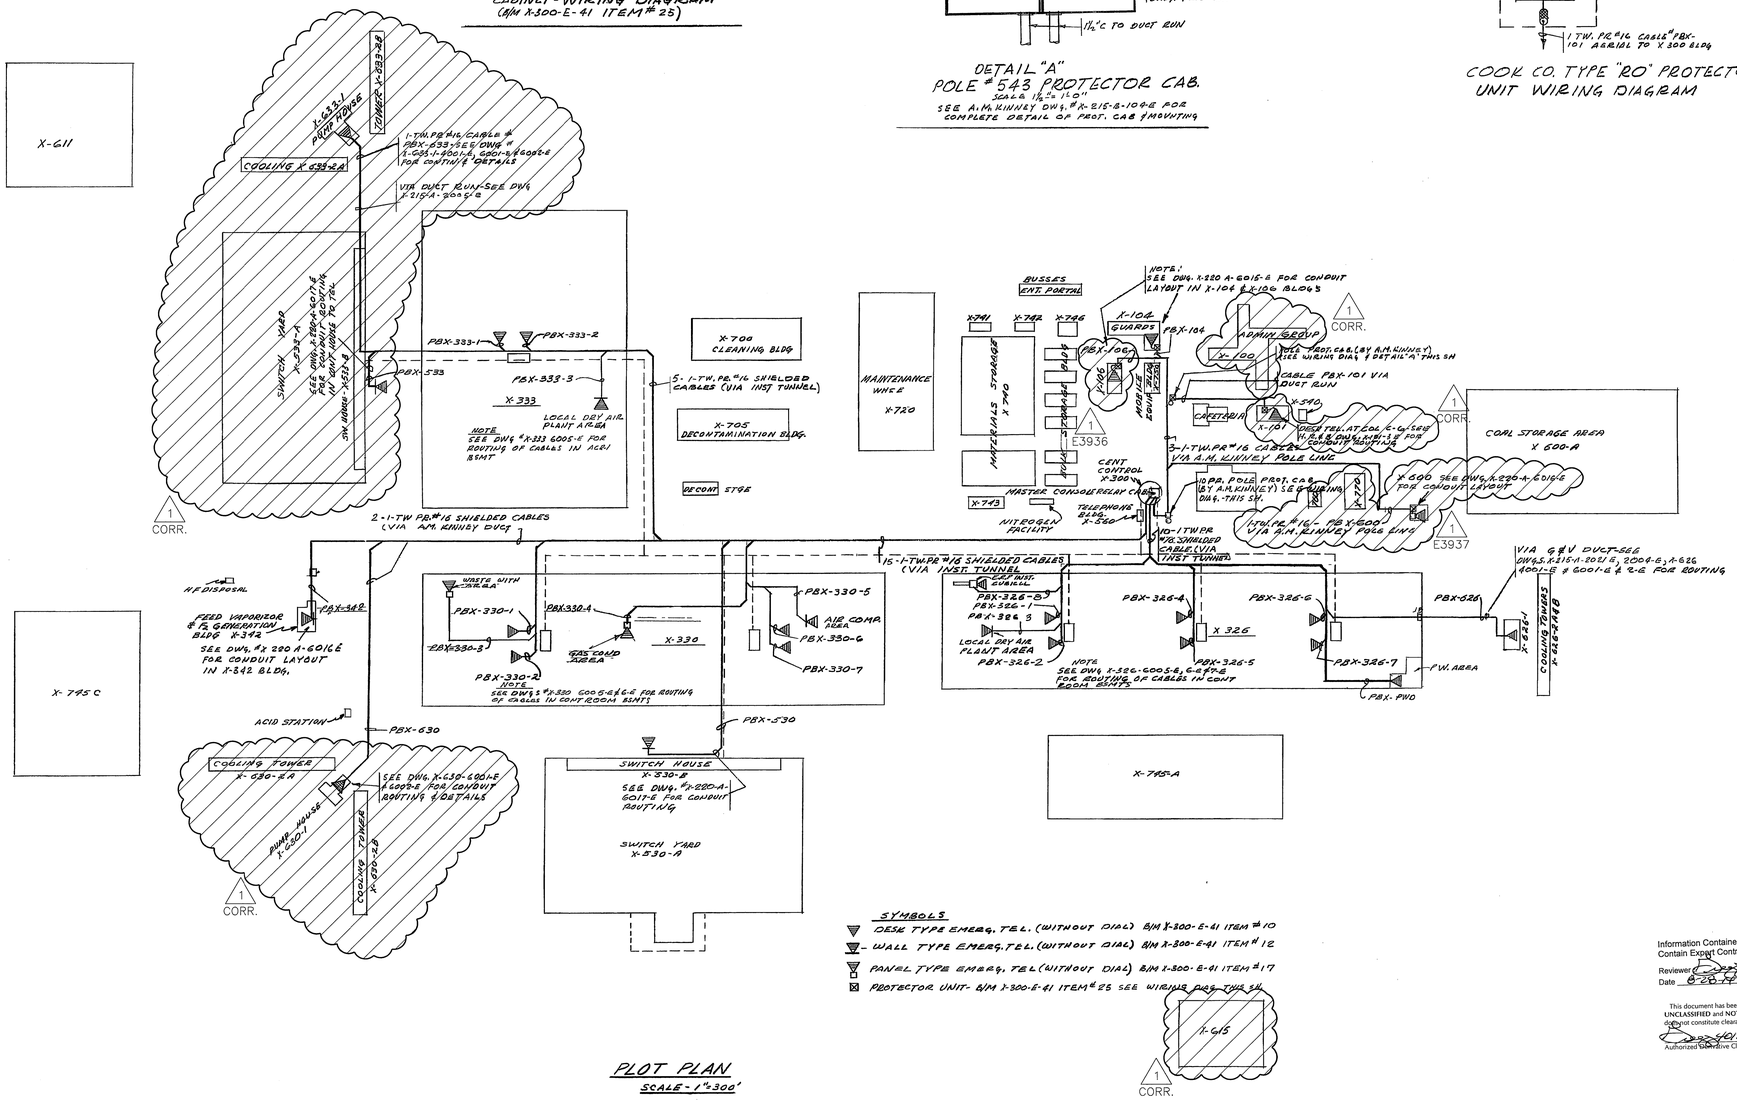

PLOT PLAN
SCALE - 1" = 300'

SYMBOLS
- DESK TYPE EMERG. TEL. (WITHOUT DIAL) B/M X-300-E-41 ITEM # 10
- WALL TYPE EMERG. TEL. (WITHOUT DIAL) B/M X-300-E-41 ITEM # 12
- PANEL TYPE EMERG. TEL (WITHOUT DIAL) B/M X-300-E-41 ITEM # 17
- PROTECTOR UNIT - B/M X-300-E-41 ITEM # 25 SEE WIRING DIAG THIS SH.

NOTES
1. SEE DWG. X-220-A-6010-E FOR EXACT ROUTING OF CABLES IN INST. TUNNEL
2. SEE A.M. KINNEY DWG X-215-B-61-E FOR EXACT ROUTING OF AERIAL CABLES
3. SEE A.M. KINNEY DWG. X-215-B-63-E FOR CABLE ALLOCATION IN UNDERGROUND DUCTS

Information Contained Within Does Not Contain Export Controlled Information
Reviewer Date 8-28-14

This document has been reviewed and is UNCLASSIFIED and NOT UCNI. This review does not constitute clearance for public release.
Authorized Derivative Classifier Date 8-28-14

This drawing requires an ECI review prior to being publically released.
DO NOT release to the public until signed below.
Signature:
Date:

APPROVED FOR RELEASE
H.H. THOMAS
DATE 10/21/13

N

REVIEWED FOR CLASSIFICATION
CLASSIFICATION unclassified
Date 12/3/74
By S A Thomas
S A Thomas Technical Writer

MF 8M / 35MM / 105MM
SEQUENCE NO. 1090

CAD OVERLAY

REV NO	DATE	ISSUED FOR	BY	APP DATE
1	10/11/13	AS-BUILT PER E3936; E3937 & CORR. DWG		10-18-13
0	12/11/63	AS BUILT AS REC'D FROM A-E WAS REV 4 DATED 10-19-55		12-11-63

UNITED STATES
ATOMIC ENERGY COMMISSION

GIFFELS & VALLET, INC.
ENGINEERS
DETROIT 26, MICHIGAN

DRAWING TITLE
PBX EMERGENCY TELEPHONE CABLE DISTRIBUTION

DRAWING APPROVED — DATE: C. J. Daigleder 12-13-52 CAD ENGINEER	DRAWING APPROVED — DATE: R.A. WALKER 1-6-53 CARBIDE CARBON CHEMICAL CO	DRAWING APPROVED — DATE: L.H. JACKSON 1-7-53 A E C ENGINEER	
DRAWN: E ROTHENHAUSER DATE 12/12/52	CHECKED: A FIELD DATE 12/16/52		JOB 51-163-X
IN CHARGE: A FIELD DATE 12/17/52	CHIEF: N.R. BJORNSON DATE 12/16/52		
PROJECT: "X" PORTSMOUTH AREA	BUILDING: SITE	SHEET: X-220-A-6001-E	1

SHEET NO	TITLE
	SEE DWG. X-220-A-6003-E & NOTES # 1 TO 3 FOR REF DWGS.

REFERENCE DRAWINGS