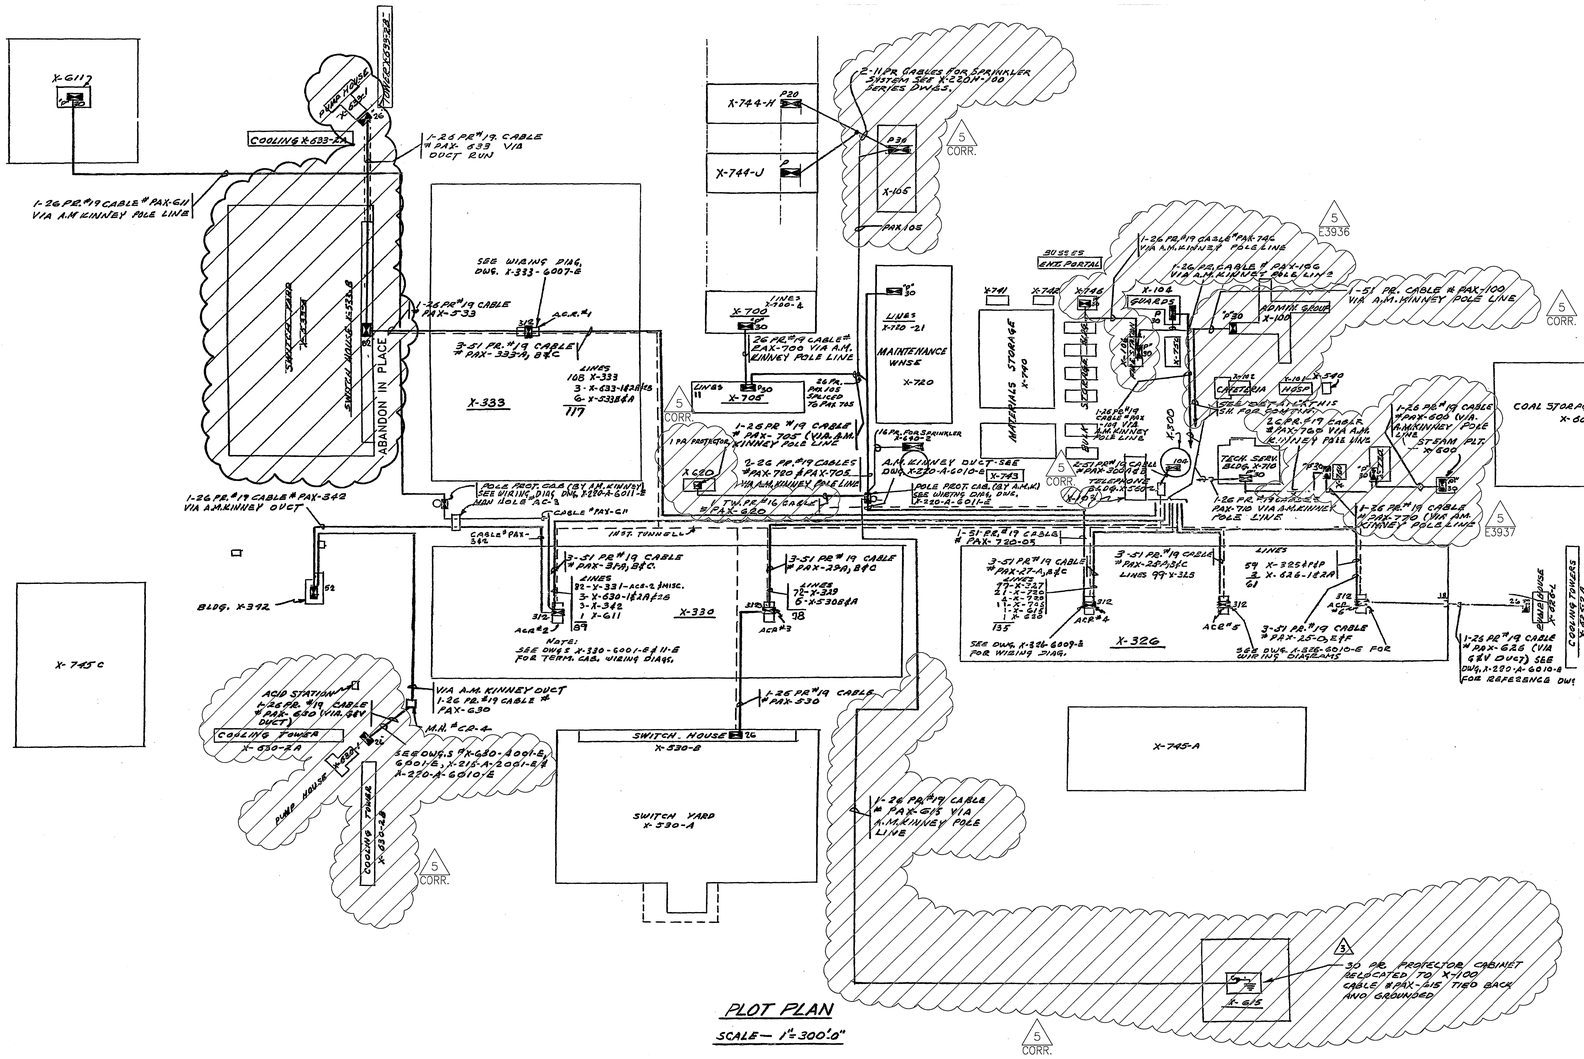

PLOT PLAN

SCALE — 1" = 300'-0"

NOTE:
312 = PROCESS TEL. TERM. CAB. NUMBER INDICATES SIZE
"P" INDICATES PROTECTOR CABINET

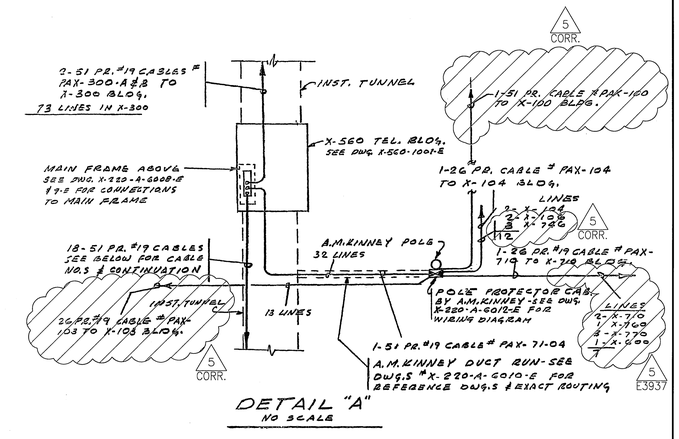

DETAIL "A"

NO SCALE

NOTES:

1. SEE B/M # X-300-E 41 FOR DESCRIPTION OF TERM. & PROTECTOR CABINETS
2. SEE DWG. X-220-A-6010-E FOR EXACT ROUTING OF CABLES IN INST. TUNNEL
3. SEE DWG.S # X-330-2055-E & 56-E, X-326-2047-E, X-220-A-4000-E TO 4004-E, X-620-2061-E & X-300-4010-E FOR INST. TUNNEL DETAILS
4. SEE DWG. # X-220-A-6003-E FOR OTHER ARCHIT. ENGINEER REFERENCE DRAWINGS.
5. SEE DWG.S X-220-A-6013-E & 14-E FOR TERM. CAB. WIRING DIAGRAMS IN OTHER ARCHIT. ENGINEER BUILDINGS
6. SEE A.M. KINNEY DWG. X-215-B-58-6 FOR EXACT ROUTING OF AERIAL CABLES

Information Contained Within Does NOT Contain Export Controlled Information
Reviewer: [signature]
Date: 8-28-97

This document has been reviewed and is UNCLASSIFIED and NOT UCNI. This review does not constitute clearance for public release.
Authorized Derivative Classifier [signature] Date 8-28-97

N

APPROVED FOR RELEASE
H. H. Thomas
Date: 10/21/13

This drawing requires an ECI review prior to being publically released.
DO NOT release to the public until signed below.
Signature: _____
Date: _____

REV. NO.	DATE	ISSUED FOR	BY	APP. DATE
5	10/11/13	AS-BUILT PER ESO E3936; E3937; & CORR. DWG.	[illegible]	10/18/13
4	3-5-10	AS BUILT PER ESO E3307	[illegible]	4/1/10
3	8/26/09	AS BUILT REVISIONS - PROJECT NO. 21100-06 AND 21220-18	[illegible]	[illegible]
2	4-6-60	AS BUILT PROJ. #23419	[illegible]	[illegible]
1	7/8/58	FIELD CHECK REVISIONS	[illegible]	7-16-58
0	3-13-58	AS BUILT AS RECV'D FROM A-E WAS REV. 7 DATED 12-9-55	MR	3-13-58 R.J.F.

UNITED STATES
ATOMIC ENERGY COMMISSION

GIFFELS & VALLET, INC.
ENGINEERS
DETROIT 26, MICHIGAN

DRAWING TITLE
PROCESS TELEPHONE CABLING DISTRIBUTION

SHEET NO.	TITLE
	SEE DWG. # X-220-A-6003-E FOR OTHER REFERENCE DWG.
X-220-A-6010-E	INST. TUNNEL COMM. CABLE ROUTING PLAN
X-220-A-6004-E	EVAC. P.A. SYSTEM SPEAKER LAYOUT
X-220-A-6003-E	P.A. SYSTEMS CABLE LAYOUT
X-220-A-6001-E	EMERG. TEL. CABLE DISTRIBUTION

REFERENCE DRAWINGS

	DRAWING APPROVED — DATE	DRAWING APPROVED — DATE	DRAWING APPROVED — DATE
	C. J. Aleighan 12-29-58 CJA	R.A. WALKER 1-16-59	R.B. SONERS 1-15-59
	ENGINEER	CARBIDE CARBON CHEM. CAL. CO.	A.E.C. ENGINEER

DRAWN	DATE	CHECKED	DATE	JOB
E. ROTHENHAUSER	10/17/58	A.J. FIELD	12/29/58	51-163-V
IN CHARGE: A.J. FIELD	DATE 10/20/58	CHIEF: N.R. BJORNSON	DATE 12/29/58	

PROJECT "X"	BUILDING	SHEET	
PORTSMOUTH AREA	SITE	X-220A-6002-E	5